

HAR. MISSISSIPPI BOARD OF WATER COMMISSIONERS

L 2001
9-21-61

WATER WELL DRILLERS LOG

Date: Sept 21, 1961, Driller: C. T. SWITZER WELL CO. County Harrison

(Name)

(1) Owner of Land: Teddy Gullett
(Name)
Robinson RD.
(Address)

(2) Location: 1/4, 1/4, Sec. T 2 R 4,
_____ miles _____ of _____
(distance) (direction) (Nearest Town)

(3) Topography: A
(Hilly) (Flat) (Level)

(4) Purpose of Well: Domestic
(Domestic Irrigation
Municipal, Industrial, Other)

Description & Color of Materials Sand, Clay, Red Clay, Shell, etc.	Thick- ness Feet	Depth Feet
<u>clay</u>	<u>0</u>	<u>20</u>
<u>sand</u>	<u>20</u>	<u>35</u>
<u>clay</u>	<u>35</u>	<u>101</u>
<u>sand fine</u>	<u>101</u>	<u>115</u>
<u>clay</u>	<u>115</u>	<u>141</u>
<u>good sand</u>	<u>141</u>	<u>202</u>

Information upon completion of well:

(1) Diameter 2" inches.

(2) Total Depth 202 feet.


(3) Water Level 22' feet below top of ground.

(4) Cased to 202, Size 2"

(5) Screen: Size 2", Length 10'

(6) Were any formations sealed against pollution?
X yes, _____ no.

If YES depth of formation _____
Why Health Dept Requirement
Drillers Remarks: _____

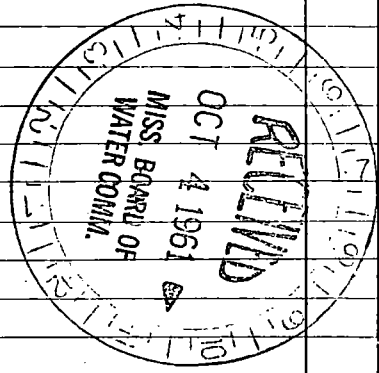

(Use Back Side)

Well No.

