

L 2004  
10-6-61

WATER WELL DRILLERS LOG

Date: 10-6, 1961, Driller: C. T. SWITZER WELL CO. County Harrison

(Name)


(1) Owner of Land:	Description & Color of Materials Sand, Clay, Red Clay, Shell, etc.	Thick- ness Feet	Depth Feet
<u>Miss Lewis Laines</u> (Name)	<u>clay</u>	<u>0</u>	<u>10</u>
<u>Rippy Road</u> (Address)	<u>sand good</u>	<u>10</u>	<u>25</u>
(2) Location: <u>1/4</u> , <u>1/4</u> , Sec. <u>T2R4</u>	<u>clay</u>	<u>75</u>	<u>170</u>
<u>2 1/2</u> miles, of <u>      </u> (distance) (direction) (Nearest Town)	<u>sand good</u>	<u>170</u>	<u>210</u>
(3) Topography: <u>X</u> (Hilly) (Flat) (Level)			
(4) Purpose of Well: <u>Domestic</u> (Domestic Irrigation Municipal, Industrial, Other)			

Information upon completion of well:

- (1) Diameter 2" inches.
- (2) Total Depth 210 feet.
- (3) Water Level 2' feet below top of ground.
- (4) Cased to 210, Size 2"
- (5) Screen: Size 2", Length 10'
- (6) Were any formations sealed against pollution?  
X yes,        no.

If YES depth of formation         
Why Health Dept Requirement

Drillers Remarks:       

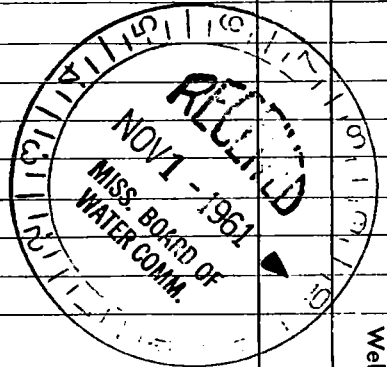

(Use Back Side)

Well No.

Handwritten notes at the top of the page, including the word "Lecture" and other illegible scribbles.

---

Handwritten notes in the middle section of the page, including the word "Lecture" and other illegible scribbles.

---

Handwritten notes at the bottom of the page, including the word "Lecture" and other illegible scribbles.