

L 2007

4-3-62


WATER WELL DRILLERS LOG



Date: 4-3, 1962, Driller: C. I. SWITZER WELL CO. County Haskell

(Name)

	Description & Color of Materials Sand, Clay, Red Clay, Shell, etc.	Thick- ness Feet	Depth Feet
(1) Owner of Land: <u>H. H. Harrison</u> <small>(Name)</small> <u>1004 - 2nd St. Hattiesburg, Miss.</u> <small>(Address)</small>	Sand	00	35
(2) Location: <u>1/4</u> , <u>1/4</u> , Sec. <u>T8 R11</u> <u> </u> miles <u> </u> of <u> </u> <small>(distance)</small> <small>(direction)</small> <small>(Nearest Town)</small>	Clay	35	60
(3) Topography: <input checked="checked" type="checkbox"/> (Hilly) <input type="checkbox"/> (Flat) <input type="checkbox"/> (Level)	Sand, gravel	60	90
(4) Purpose of Well: <u>Domestic</u> <small>(Domestic Irrigation Municipal, Industrial, Other)</small>	Clay	90	110
Information upon completion of well:			
(1) Diameter <u>2</u> inches.	Sand, gravel	162	181
(2) Total Depth <u>181</u> feet.			
(3) Water Level <u>15</u> feet below top of ground.			
(4) Cased to <u>181</u> , Size <u>2"</u>			
(5) Screen: Size <u>2"</u> , Length <u>10'</u>			
(6) Were any formations sealed against pollution? <u>✓</u> yes, <u> </u> no.			
If YES depth of formation <u> </u>			
Why <u>Health Dept. Requirement</u>			
Drillers Remarks: <u> </u>			

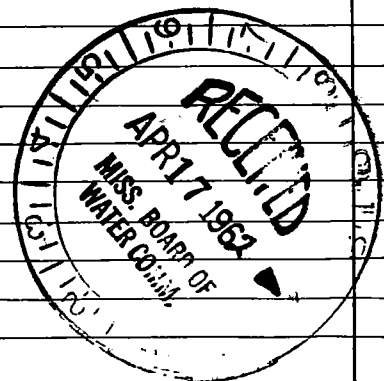

(Use Back Side)

Well No.

1870

July 12

1870
1871
1872
1873
1874
1875

The following is a list of the names of the persons who have been admitted to the membership of the Society since the last meeting of the Executive Committee, held on the 12th inst. The names are given in the order in which they were admitted.

MEMBERS

1870
1871
1872
1873
1874
1875



The following is a list of the names of the persons who have been admitted to the membership of the Society since the last meeting of the Executive Committee, held on the 12th inst. The names are given in the order in which they were admitted.