

L 2008

5-12-62

WATER WELL DRILLERS LOG



Date: 5-12, 1962, Driller: C. T. SWITZER WELL CO. County: Harrison

(Name)

(1) Owner of Land: Carroll Williams (Name)

Three Rivers Rd, Hattiesburg (Address)

(2) Location: 1/4, 1/4, Sec. T7 R11

miles of (distance) (direction) (Nearest Town)

(3) Topography: (Hilly) (Flat) (Level) [checked Flat]

(4) Purpose of Well: Domestic (Domestic Irrigation, Municipal, Industrial, Other)

Information upon completion of well:


- (1) Diameter 2" inches.
(2) Total Depth 66 feet.
(3) Water Level 19' feet below top of ground.
(4) Cased to 66', Size 2"
(5) Screen: Size 2", Length 5'
(6) Were any formations sealed against pollution? [checked yes]

If YES depth of formation
Why Health Department Requirement
Drillers Remarks:

Description & Color of Materials Sand, Clay, Red Clay, Shell, etc.

Thick-ness Feet Depth Feet

Table with 3 columns: Description & Color of Materials, Thick-ness Feet, Depth Feet. Rows contain handwritten entries: Clay (0-15), Sand (15-40), Clay (40-50), Sand (50-61), Sand, gravel (61-66).

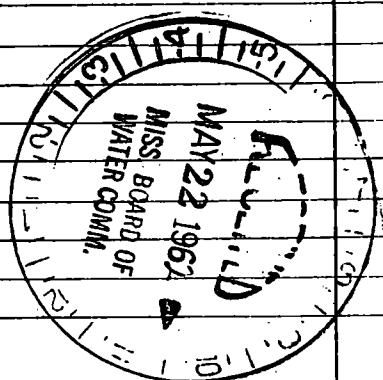

(Use Back Side)

Well No.

Handwritten header text, possibly a title or date, located at the top of the page.

Large block of handwritten text in the upper middle section, appearing to be a list or series of entries.

Large block of handwritten text in the middle section, continuing the list or entries.

Large block of handwritten text in the lower section, possibly concluding the document.