

(2)

L 2010  
6-25-62

WATER WELL DRILLERS LOG

Date: 6-25, 1962, Driller: C. T. SWITZER WELL CO. County: Harrison

(Name)

(1) Owner of Land: John Eaton  
(Name)  
John Clark Rd, Hufport  
(Address)

(2) Location: 1/4, 1/4, Sec. T7 R11,  
\_\_\_\_\_ miles \_\_\_\_\_ of \_\_\_\_\_  
(distance) (direction) (Nearest Town)

(3) Topography:  (Hilly)  (Flat)  (Level)

(4) Purpose of Well: Domestic  
(Domestic Irrigation  
Municipal, Industrial, Other)

Description & Color of Materials Sand, Clay, Red Clay, Shell, etc.	Thick- ness Feet	Depth Feet
<u>Clay</u>	<u>00</u>	<u>20</u>
<u>Sand</u>	<u>20</u>	<u>30</u>
<u>Clay</u>	<u>30</u>	<u>60</u>
<u>Clay &amp; sand shks</u>	<u>60</u>	<u>80</u>
<u>Clay</u>	<u>80</u>	<u>100</u>
<u>Sand, fine</u>	<u>100</u>	<u>120</u>
<u>Sand &amp; clay shks</u>	<u>120</u>	<u>140</u>
<u>Sand, fine</u>	<u>140</u>	<u>190</u>

Information upon completion of well:

(1) Diameter 2 inches.

(2) Total Depth 190 feet.

(3) Water Level 43' 6" feet below top of ground.


(4) Cased to 190', Size 2"

(5) Screen: Size 2", Length 10'

(6) Were any formations sealed against pollution?  
 yes,  no.

If YES depth of formation \_\_\_\_\_  
Why Health Dept. Requirement

Drillers Remarks: \_\_\_\_\_

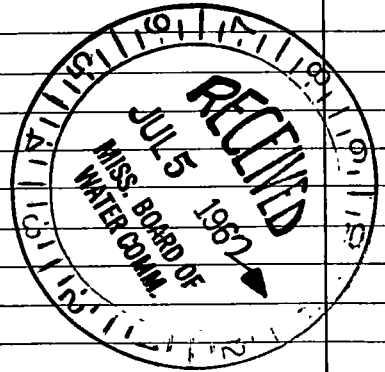

(Use Back Side)

Well No.

*[Faint, illegible handwritten text, possibly bleed-through from the reverse side of the page.]*

*[Faint handwritten word or phrase.]*

*[Faint handwritten notes or a list of items, possibly including numbers and names.]*

*[Faint handwritten text at the bottom of the page.]*