

HAR. 2011

WATER WELL DRILLERS LOG

Date: Aug 28, 1962 Driller: Joe Miller County Harrison
(Name)


(1) Owner of Land:	Description & Color of Materials	Thick-ness Feet	Depth Feet
<u>Ernest Caldwell</u> (Name)	<u>Surface</u>	<u>8</u>	<u>8</u>
<u>Rt. 1 Box 13 Sheppard Miss</u> (Address)	<u>White Sand</u>	<u>20</u>	<u>28</u>
(2) Location: <u>1/4</u> , <u>1/4</u> , Sec. <u>T 7 R 4</u>	<u>Blue Clay</u>	<u>54</u>	<u>82</u>
<u>2</u> miles <u>West</u> of <u>Sheppard</u> (distance) (direction) (Nearest town)	<u>Blue Sand - Fine</u>	<u>16</u>	<u>98</u>
(3) Topography: <u>Flat</u> (Hilly) (Flat) (Level)	<u>Blue Clay</u>	<u>54</u>	<u>152</u>
(4) Purpose of Well: <u>Domestic</u> (Domestic Irrigation Municipal, Industrial, Other)	<u>Sand - Blue - Fine</u>	<u>38</u>	<u>190</u>
	<u>Sand - Blue - Fair</u>	<u>40</u>	<u>220</u>
	<u>Sand - Fine</u>	<u>11</u>	<u>231</u>
	<u>Hard Blue Clay</u>	<u>6</u>	<u>237</u>

Information upon completion of well:

- (1) Diameter 2" inches.
- (2) Total Depth 237' feet.
- (3) Water Level Flowing feet below top of ground.
- (4) Cased to 210', Size 2"
- (5) Screen: Size 2", Length 10'
- (6) Were any formations sealed against pollution?
_____ yes, _____ no.

If YES depth of formation _____
Why _____
Drillers Remarks: _____

*Used 1 1/2" Gal Pipe
between the bottom
sand*

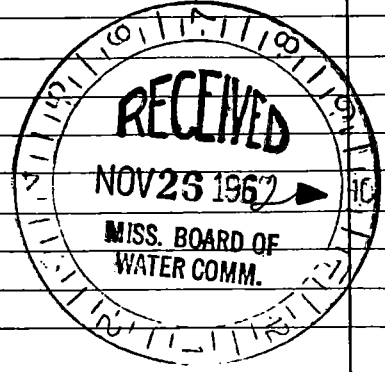

(Use Back Side)

Well No.

[The page contains extremely faint and illegible handwritten text, likely bleed-through from the reverse side of the paper. The text is scattered across the page and is not readable.]