

L

HAR. MISSISSIPPI BOARD OF WATER COMMISSIONERS

L 2012
9-11-62

WATER WELL DRILLERS LOG

Date: Sept. 11 1962, Driller: McB Drilling Co County Harrison

(Name)

(1) Owner of Land: North Cuffport Water Works
 (Name)
Cuffport, Miss.
 (Address)
North Cuffport next to
 (2) Location: 1/4, 1/4, Sec. T 7 N
Federal Colored Housing Project
 miles _____ of _____
 (distance) (direction) (Nearest Town)
 (3) Topography: Flat
 (Hilly) (Flat) (Level)
 (4) Purpose of Well: Private Water System
 (Domestic Irrigation
 Municipal, Industrial, Other)

Description & Color of Materials Sand, Clay, Red Clay, Shell, etc.	Thick- ness Feet	Depth Feet
Clay	18	18
Sand	8	26
Blue Clay	64	90
Sand	30	120
Blue Clay	140	260
Fine Sand	30	290
Blue Clay	107	397
Grey Sand	43	440
Blue Clay	15	455
Coarse Sand (Grey)	35	490

Information upon completion of well:


105 FT 4" X Balance 3"

(1) Diameter _____ inches.
 (2) Total Depth 490 feet.
 (3) Water Level 0 feet below top of ground.
 (4) Cased to 470, Size 4" X 3"
 (5) Screen: Size 8/16 X 3", Length 20 FT.
 (6) Were any formations sealed against pollution?
 _____ yes, _____ no.

If YES depth of formation _____

Why _____

Drillers Remarks: _____

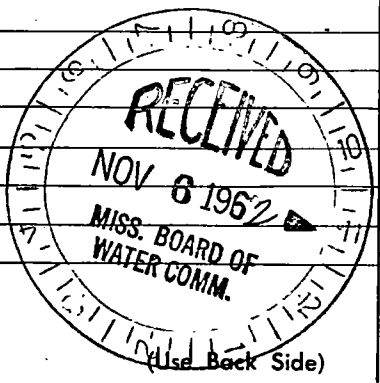

Well No.

