

HAR.

MISSISSIPPI BOARD OF WATER COMMISSIONERS

S 179304

5-1-63

WATER WELL DRILLERS LOG

Date: May 1, 1963, Driller: M&B Drilling Co. County Harrison

(Name)

(1) Owner of Land: R. Porter
(Name)

1321 Second St. Gulfport, Miss
(Address)

(2) Location: 1/4, 1/4, Sec. TR 11

Beach Hill rd
miles, of
(distance) (direction) (Nearest Town)

(3) Topography: Flt
(Hilly) (Flat) (Level)

(4) Purpose of Well: Lawn
(Domestic Irrigation, Municipal, Industrial, Other)

Description & Color of Materials Sand, Clay, Red Clay, Shell, etc.	Thick- ness Feet	Depth Feet
<u>Surface Clay Fill</u>	<u>3</u>	<u>3</u>
<u>White Sand</u>	<u>17</u>	<u>20</u>
<u>Black Sand</u>	<u>10</u>	<u>30</u>
<u>Black Clay</u>	<u>12</u>	<u>42</u>
<u>Blue Clay</u>	<u>94</u>	<u>136</u>
<u>Gray Sand</u>	<u>12</u>	<u>148</u>
<u>Clam shells - at 80 FT with Blue Clay</u>		

Information upon completion of well:

(1) Diameter 2 inches.

(2) Total Depth 148 feet.

(3) Water Level 9 feet below top of ground.

(4) Cased to 146, Size 2"

(5) Screen: Size 2" X 8 ft, Length 6 FT


(6) Were any formations sealed against pollution?

yes, no.

If YES depth of formation

Why

Drillers Remarks:

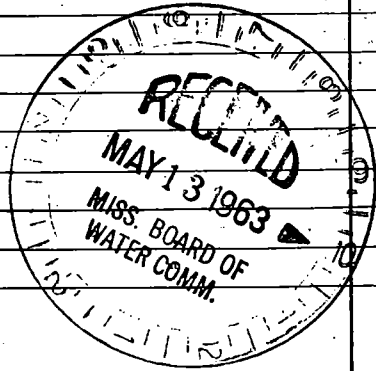

(Use Back Side)

Well No.

