

HAR.

MISSISSIPPI BOARD OF WATER COMMISSIONERS

L 2018

7-3-63

WATER WELL DRILLERS LOG


Date: 7/3, 1963, Driller: Hattalburg Beton County, Harrison  
(Name)

| (1) Owner of Land: <u>Chas. Ladner</u><br>(Name)  | Description & Color of Materials<br>Sand, Clay, Red Clay, Shell, etc. | Thick-<br>ness<br>Feet | Depth<br>Feet |
|---|---|------------------------|---------------|
| <u>Hwy. 49 + Rippy Rd. Sulphur</u><br>(Address)   | <u>Red clay</u>   | <u>0-5</u>             |               |
| (2) Location: <u>1/4</u> , <u>1/4</u> , Sec. <u>T 7 R 11</u>                                  | <u>white sand</u>   | <u>5-100</u>           |               |
| <u>2</u> miles <u>N</u> , of <u>Spt.</u><br>(distance) (direction) (Nearest Town)             | <u>Blue Clay</u>  | <u>100-180</u>         |               |
| (3) Topography: <u>X</u><br>(Hilly) (Flat) (Level)  | <u>Blue sand</u>  | <u>180-122</u>         |               |
| (4) Purpose of Well: <u>Domestic</u><br>(Domestic Irrigation<br>Municipal, Industrial, Other) |   |                        |               |

Information upon completion of well:

- (1) Diameter 2" inches.
- (2) Total Depth 222 feet.
- (3) Water Level 1 feet below top of ground.
- (4) Cased to \_\_\_\_\_, Size \_\_\_\_\_
- (5) Screen: Size 2", Length 10'
- (6) Were any formations sealed against pollution?  
\_\_\_\_\_ yes, X no.

If YES depth of formation \_\_\_\_\_  
Why \_\_\_\_\_  
Drillers Remarks: \_\_\_\_\_

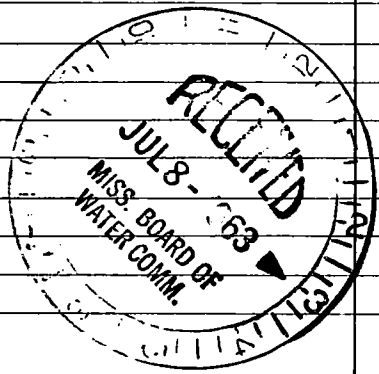

(Use Back Side)

Well No.

