

L 2019
7-12-63

WATER WELL DRILLERS LOG

Date: 7-12, 1963, Driller: C. T. SWINNER WELL CO. County: Norfolk
(Name)


(1) Owner of Land: Paul [unclear]
(Name)
Reef Runge, Hwy 90, Blueport
(Address)
(2) Location: 1/4, 1/4, Sec. T 8 R 11
_____ miles _____ of _____
(distance) (direction) (Nearest Town)
(3) Topography: Level
(Hilly) (Flat) (Level)
(4) Purpose of Well: Commercial
(Domestic Irrigation, Municipal, Industrial, Other)

Information upon completion of well:

(1) Diameter 4" inches.
(2) Total Depth 615 feet.
(3) Water Level ground feet below top of ground.
(4) Cased to 615', Size 4"
(5) Screen: Size 4", Length 20'
(6) Were any formations sealed against pollution?
yes, _____ no.

If YES depth of formation _____
Why None met requirement
Drillers Remarks: _____

Description & Color of Materials Sand, Clay, Red Clay, Shell, etc.	Thickness Feet	Depth Feet
Clay	20	20
sand	24	65
clay	65	105
sand	105	125
clay	125	146
sand	146	166
sand & clay	166	206
sand	206	226
clay	226	304
clay, hard	304	324
clay	324	344
sand	344	362
clay	362	389
sand	389	441
shell	441	511
sand & shell	511	531
shell	531	551
sand, hard	551	613
sand, heavy	613	624

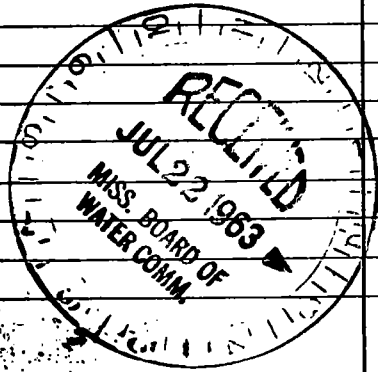

(Use Back Side)

Well No.

