

L 2021

2-20-64 WATER WELL DRILLERS LOG

Date: Feb 20, 1964, Driller: Joe Miller County Harrison  
(Name)

(1) Owner of Land: Dollarhide.  
(Name)  
Court House St Road, Sulfur,  
(Address)  
(2) Location: 7 R 11  
7 miles of Sulfur,  
(distance) (direction) (Nearest Town)  
(3) Topography: Flat (along Bay)  
(Hilly) (Flat) (Level)  
(4) Purpose of Well: Domestic.  
(Domestic Irrigation  
Municipal, Industrial, Other)


Description & Color of Materials Sand, Clay, Red Clay, Shell, etc.	Thick- ness Feet	Depth Feet
<u>Test</u>	<u>15</u>	<u>15</u>
<u>Muck Wood &amp; Clay</u>	<u>32</u>	<u>47</u>
<u>White &amp; Brown Clay</u>	<u>108</u>	<u>155</u>
<u>Blue Clay</u>	<u>125</u>	<u>280</u>
<u>Dark Wood &amp; Clay</u>	<u>4</u>	<u>284</u>
<u>Hard Blue Clay</u>	<u>6</u>	<u>290</u>
<u>Hard Blue</u>	<u>10</u>	<u>300</u>
<u>Sand, Fair</u>	<u>6</u>	<u>306</u>
<u>Sand</u>	<u>10</u>	<u>316</u>
<u>Hard Blue Clay</u>	<u>5</u>	<u>321</u>

Information upon completion of well:

(1) Diameter 2 inches.  
(2) Total Depth 321 feet.  
(3) Water Level Flowing 500 PPM feet below top of ground. 2' Head  
(4) Cased to 306, Size 2"  
(5) Screen: Size 2" Length 10"  
(6) Were any formations sealed against pollution?  
yes, \_\_\_\_\_ no.

7' Seal Pipe

If YES depth of formation 63'  
Why Swamp, Wood & Muck  
Drillers Remarks: Down to 47'  
Feet. Seal to 63'  
Feet With 4" Pipe.

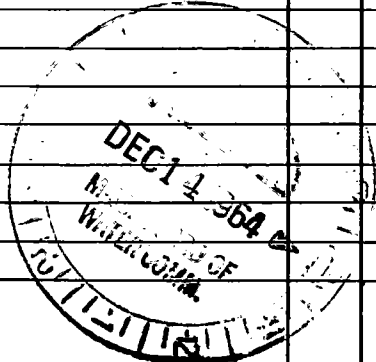

(Use Back Side)

Well No.

Hand Road

Alta 49

Pass Rd

Count Howard St Rd.

Dillon Hill

Camp

Bernard

