

HAR.

MISSISSIPPI BOARD OF WATER COMMISSIONERS

L 2023
7-24-64

L 291512

WATER WELL DRILLERS LOG

Date: 7-24-64, 1964, Driller: C. T. SWITZER WELL CO County Harrison

(Name)

(1) Owner of Land: Henry Sneed
(Name)

434 East Beach Gulfport
(Address)

(2) Location: 1/4, 1/4 Sec. T 8 R 11

1/2 miles of SW (direction), of 8 R 11 (Nearest Town)

(3) Topography: (Hilly) (Flat) (Level)

(4) Purpose of Well: Domestic
(Domestic Irrigation, Municipal, Industrial, Other)

Information upon completion of well:

(1) Diameter 2" inches.

(2) Total Depth 321' feet.

(3) Water Level 4' feet below top of ground.

(4) Cased to 321', Size _____

(5) Screen: Size 8 ga, Length 10'

(6) Were any formations sealed against pollution?


yes, no.

If YES depth of formation _____

Why Health Dept Requirement

Drillers Remarks: _____

Description & Color of Materials Sand, Clay, Red Clay, Shell, etc.	Thick- ness Feet	Depth Feet
Sand	00	25
Clay	25	50
Sand	50	70
Clay	70	120
Clay + sand str	120	140
Sand	140	152
Clay	152	160
Sand, fair	160	180
Clay	180	200
Sand + clay str	200	220
Sand	220	230
Clay	230	240
Sand, fair	240	260
Sand	260	270
Clay	270	280
Sand, good	280	321

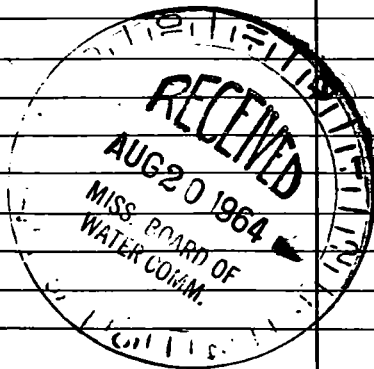

(Use Back Side)

Well No.

