

WATER WELL DRILLERS LOG

Date: 8-7-64, 19\_\_\_, Driller: C. E. SWITZER WELL CO County Harrison  
 (Name)


(1) Owner of Land: T. S. Clower  
 (Name)  
424 East Bend, Gulfport  
 (Address)  
 (2) Location: 1/4 1/4, Sec. T R U  
Sutler  
 miles (distance) of (direction) (Nearest Town)  
 (3) Topography:  (Hilly)  (Flat)  (Level)  
 (4) Purpose of Well: Domestic  
 (Domestic Irrigation, Municipal, Industrial, Other)

Information upon completion of well:

(1) Diameter 4x3" inches.  
 (2) Total Depth 809' feet.  
 (3) Water Level = 9' feet below top of ground.  
 (4) Cased to 809, Size 4x3"  
 (5) Screen: Size 3", Length 30'  
 (6) Were any formations sealed against pollution?  
X yes, \_\_\_ no.

If YES depth of formation \_\_\_\_\_  
 Why Health Dept Requirements  
 Drillers Remarks: \_\_\_\_\_

Description & Color of Materials Sand, Clay, Red Clay, Shell, etc.	Thick- ness Feet	Depth Feet
Sand	00	30
Clay	30	44
Sand streaks	44	64
Sand	64	77
Clay	77	129
Sand	129	158
Clay	158	164
Sand	164	176
Clay	176	184
Sand streaks	184	205
Clay	205	219
Sand	219	236
Clay	236	266
Sand streaks	266	280
Sand, good	280	322
Clay	322	366
Clay + sand streaks	366	386
Clay	386	446
Shale	446	486
Clay + shale	486	508
Sand	508	518
Clay	518	548
Shale	548	568
Clay	568	582
Sand	582	588
Sand, good	588	644
Clay	644	650
Sand streaks	650	671
Sand	671	683
Clay	683	691
Clay + sand streaks	691	711
Sand, "good"	711	809

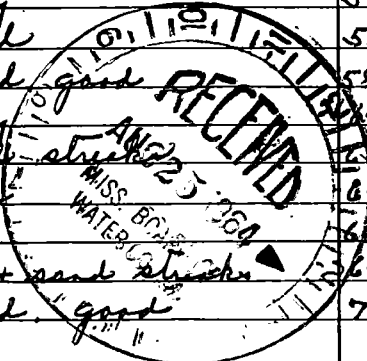

(Use Back Side)

Well No.

085-3446