

L 2527

9-10-64

WATER WELL DRILLERS LOG

Date: 9-10-64, 19___, Driller: C. T. SWITZER WELL CO County Harrison

(Name)

(1) Owner of Land: Ed Sugeh
 (Name)

Rt 3 Box 25 Hillcrest Road
 (Address) Georgetown

(2) Location: ___ 1/4, ___ 1/4, Sec. T2 R11,
 ___ miles, of ___
 (distance) (direction) (Nearest Town)

(3) Topography: (Hilly) (Flat) (Level)

(4) Purpose of Well: Domestic
 (Domestic Irrigation
 Municipal, Industrial, Other)

Description & Color of Materials Sand, Clay, Red Clay, Shell, etc.	Thick- ness Feet	Depth Feet
<u>Sand</u>	<u>0</u>	<u>11</u>
<u>Clay</u>	<u>11</u>	<u>63</u>
<u>Sand + gravel</u>	<u>63</u>	<u>105</u>
<u>Red Sand</u>	<u>105</u>	<u>126</u>
<u>Sand + gravel</u>	<u>126</u>	<u>147</u>
<u>Red Sand</u>	<u>147</u>	<u>168</u>
<u>Sand + gravel</u>	<u>168</u>	<u>189</u>
<u>Clay</u>	<u>189</u>	<u>262</u>
<u>Sand</u>	<u>262</u>	<u>273</u>
<u>Sand, gravel</u>	<u>273</u>	<u>294</u>

Information upon completion of well:

(1) Diameter 2" inches.

(2) Total Depth 294 feet.

(3) Water Level 10' feet below top of ground.

(4) Cased to 294', Size 2"


(5) Screen: Size 2", Length 10'

(6) Were any formations sealed against pollution?
 yes, ___ no.

If YES depth of formation _____

Why Health Dept. Permits.

Drillers Remarks: _____

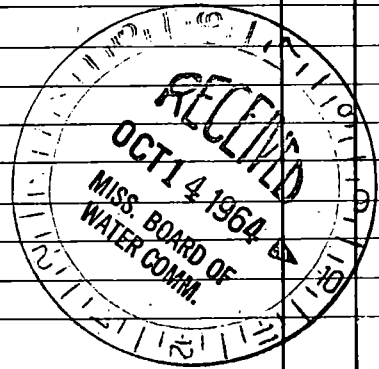

Well No.

(Use Back Side)

