

HAR.

MISSISSIPPI BOARD OF WATER COMMISSIONERS

L 2028  
12-64

WATER WELL DRILLERS LOG

Date: 12, 1964, Driller: C. T. Surtz Well County Harrison  
(Name)

(1) Owner of Land: Lesley Smith  
(Name)  
Corner of Park St + South  
Carolina Avenue, Gulfport  
(Address)  
New

(2) Location: 1/4, 1/4, Sec. T7 R11  
miles of  
(distance) (direction) (Nearest Town)

(3) Topography: \_\_\_\_\_  
(Hilly) (Flat) (Level)

(4) Purpose of Well: Domestic  
(Domestic Irrigation  
Municipal, Industrial, Other)

Description & Color of Materials Sand, Clay, Red Clay, Shell, etc.	Thick- ness Feet	Depth Feet
Sand	0	5
Clay	5	23
Mixed sand + clay	23	44
Clay	44	105
Sand	105	117
Clay	117	175
Mixed clay + sand	175	185
Sand, fine	185	195
Sand, fair	195	261


Information upon completion of well:

- (1) Diameter 3x2 inches.
- (2) Total Depth 261 feet.
- (3) Water Level 6' feet below top of ground.
- (4) Cased to 261', Size 3x2
- (5) Screen: Size 8ga, Length 15'
- (6) Were any formations sealed against pollution?  
Y yes, \_\_\_\_\_ no.

If YES depth of formation \_\_\_\_\_

Why Health Dept Regulation

Drillers Remarks: \_\_\_\_\_

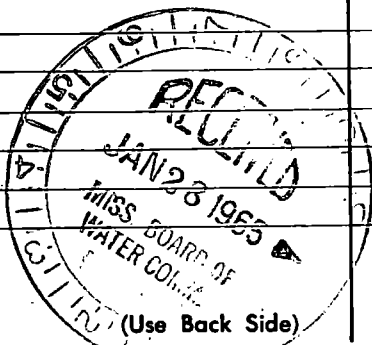

Well No.

