


HAR. MISSISSIPPI BOARD OF WATER COMMISSIONERS

L 2029  
1-17-65

WATER WELL DRILLERS LOG

Date: 1-17-65, 1965, Driller: C. T. Surtz Well 6 County Harrison  
(Name)

	Description & Color of Materials Sand, Clay, Red Clay, Shell, etc.	Thick- ness Feet	Depth Feet
(1) Owner of Land: <u>Louis Letimer</u> <small>(Name)</small> <u>End of Letimer Road - 3/4 mile</u> <u>North on Hedrick Rd left</u> <small>(Address)</small>	<u>Drilled deeper</u>		
(2) Location: <u>1/4</u> , <u>1/4</u> , Sec. <u>7</u> <u>11</u> <u>R</u>  <u>_____</u> miles <u>_____</u> of <u>_____</u> <small>(distance) (direction) (Nearest Town)</small>	<u>Sand</u> <u>Clay</u> <u>Sand</u> <u>Sand, good</u> <u>Clay</u> <u>Sand</u> <u>Sand, good</u>	<u>123</u> <u>141</u> <u>154</u> <u>165</u> <u>207</u> <u>235</u> <u>249</u>	<u>141</u> <u>154</u> <u>165</u> <u>207</u> <u>235</u> <u>249</u>
(3) Topography: _____ <small>(Hilly) (Flat) (Level)</small>			
(4) Purpose of Well: <u>Domestic</u> <small>(Domestic Irrigation Municipal, Industrial, Other)</small>			
Information upon completion of well:			
(1) Diameter <u>2</u> inches.			
(2) Total Depth <u>291</u> feet.			
(3) Water Level <u>29' 4"</u> feet below top of ground.			
(4) Cased to <u>291</u> , Size <u>2"</u>			
(5) Screen: Size <u>2"</u> , Length <u>10' 8"</u>			
(6) Were any formations sealed against pollution?  <u>X</u> yes, _____ no.			
If YES depth of formation _____			
Why <u>Health Dept. Reqs.</u>			
Drillers Remarks: _____ _____ _____			

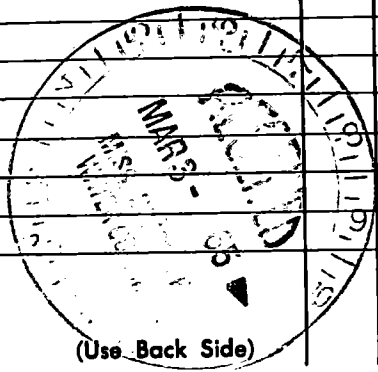

(Use Back Side)

Well No.

