

HAR.

MISSISSIPPI BOARD OF WATER COMMISSIONERS

L 2032

7-26-65

WATER WELL DRILLERS LOG

Date: July 26, 1965, Driller: Joe Miller County Harrison

(Name)

(1) Owner of Land: Be. Roberson

(Name)

RRT Deaneau Rd. Gulfport

(Address)

(2) Location: 1/4, 1/4, Sec. T7R11

5 miles North of Gulfport

(distance)

(Direction)

(Nearest Town)

(3) Topography: Flat

(Hilly)

(Flat)

(Level)

(4) Purpose of Well: Domestic

(Domestic Irrigation  
Municipal, Industrial, Other)

Description & Color of Materials  
Sand, Clay, Red Clay, Shell, etc.

Thick-  
ness  
Feet

Depth  
Feet

Surface

5

5

Tan Clay

19

24

Blue Clay

52

76

Blue Sand (Good)

36

112

Soft Clay + Sand

4

116

Hard Blue Clay

279

395

Gray Sand (Fine)

5

400

(Fair)

5

405

Hard Blue Clay

85

490

Gray Sand (Fine)

16

506

" " Little Pelka

10

516

" " (Fair)

21

537

" " (Good)

25

562

Still Sand "

Information upon completion of well:

(1) Diameter 2" inches.

(2) Total Depth 562' feet.

(3) Water Level 20' feet below top of ground.

(4) Cased to 548', Size 2"

(5) Screen: Size 2", Length 10'

(6) Were any formations sealed against pollution?

yes, no.

If YES depth of formation.


Why

Drillers Remarks: Made Well in

76-112 Formation

Few yrs, Beck, Color

Chatham N.C.

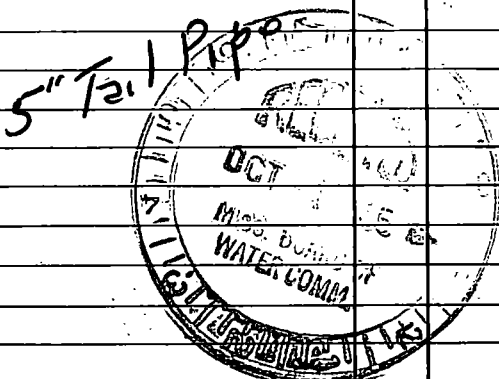

(Use Back Side)

Well No.

B<sub>0</sub> Riberson

Deeudeaux Rd

Kilm Rd.

HKy  
19

old HKy

