

HAR. MISSISSIPPI BOARD OF WATER COMMISSIONERS

L 2033  
8-13-65

C 283103  
WATER WELL DRILLERS LOG

Date: 8-13-65, 19\_\_\_, Driller: C. T. Switzer Well Co County Harrison  
(Name)

(1) Owner of Land: Henry W. Mable  
(Name)  
Ripley Road N Gulfport Miss  
(Address)

(2) Location: 1/4, 1/4, Sec 2 T 7 R 11  
\_\_\_\_\_ miles \_\_\_\_\_ of \_\_\_\_\_  
(distance) (direction) (Nearest Town)

(3) Topography: X  
(Hilly) (Flat) (Level)

(4) Purpose of Well: Domestic  
(Domestic Irrigation  
Municipal, Industrial, Other)

Description & Color of Materials Sand, Clay, Red Clay, Shell, etc.	Thick- ness Feet	Depth Feet
Clay	0	11
Sand	11	22
Clay	22	58
Sand	58	62
Clay	62	82
Sand	82	102
Clay + sand streaks	102	122
Clay	122	139
Sand	139	142
Sand, fair	142	162
Sand, good	162	192

Information upon completion of well:


- (1) Diameter 2 inches.
- (2) Total Depth 192 feet.
- (3) Water Level 1' feet below top of ground.
- (4) Cased to 192, Size 2"
- (5) Screen: Size 2", Length 10' 8 1/2"
- (6) Were any formations sealed against pollution?  
X yes, \_\_\_\_\_ no.

If YES depth of formation \_\_\_\_\_

Why \_\_\_\_\_

Drillers Remarks: Health Dept

Payments

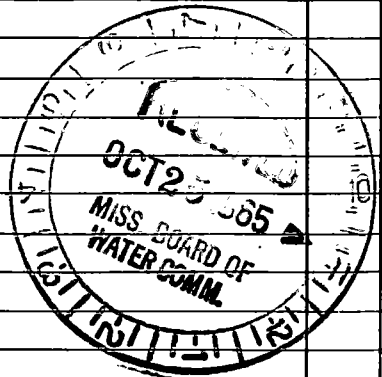

(Use Back Side)

Well No.

