

Harrison

MISSISSIPPI BOARD OF WATER COMMISSIONERS

3-66 2039


WATER WELL DRILLERS LOG

Date: 3-15-66, 19, Driller: B. T. Sauter Wells B County Harrison (Name)

(1) Owner of Land: Concrete Products, Inc. (Name)
2801-33rd St Sulphur (Address)
West of 10 (Address) Railroad
(2) Location: 1/4, 1/4, Sec. T8 R11
miles of (distance) (direction) (Nearest Town)
(3) Topography: X (Hilly) (Flat) (Level)
(4) Purpose of Well: Commercial (Domestic Irrigation, Municipal, Industrial, Other)

Table with 3 columns: Description & Color of Materials (Sand, Clay, Red Clay, Shell, etc.), Thickness Feet, Depth Feet. Rows include: Mixed sand & clay, Clay, Sand, fine, Sand, fair, Clay, Mixed, Sand, Clay, Sand, Clay, Sand, Clay, Shale, Clay + shale, Clay, Clay + shale, Clay + sandy shale, Shale, Clay, Shale, Clay, Sand, Clay, Fine sand w clay str, Sand, Clay.

Information upon completion of well:
(1) Diameter 2" x 4" inches.
(2) Total Depth 1180 feet.
(3) Water Level 6' - feet below top of ground. top 126' - 4"
(4) Cased to 1166, Size 2" x 4"
(5) Screen: Size 8 gauge, Length 30'
(6) Were any formations sealed against pollution? X yes, no.
If YES depth of formation
Why: Health Dept Permits
Drillers Remarks:

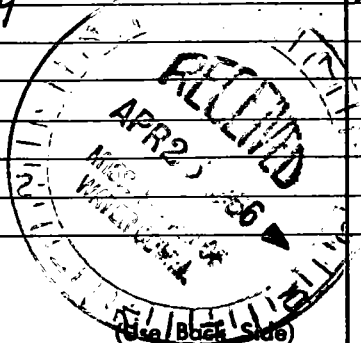

Well No.

