

MISSISSIPPI DEPARTMENT OF NATURAL RESOURCES

Bureau of Land and Water Resources

Southport Mall

P.O. Box 10631

Jackson, Mississippi 39209

WATER WELL DRILLERS LOG

Harrison
~~# 2040~~
L 2040

11/23/81
 date well completed

19 Lyman Well Co.
 firm name

Harrison
 county well located

LANDOWNER	description of formations encountered	from	to
<p><u>Highside Chemicals</u> <u>Seaway Rd.</u> <u>Gulfport, Md</u> (mailing address)</p>	<p><u>Blue gumbo</u> <u>Clay</u> <u>Sand</u></p>	<p><u>0</u> <u>10</u> <u>180</u></p>	<p><u>180</u> <u>200</u></p>
<p>WELL LOCATION:</p> <p>sec. <u>8</u> T. <u>7</u> N. R. <u>14</u> E. of <u>Gpt</u> (distance) miles (direction) (nearest town)</p>			
<p>WELL PURPOSE: (home, irrigation, municipal, industrial)</p>			
<p>WELL COMPLETION DATA:</p> <p>(1) diameter (inches) <u>2"</u></p> <p>(2) total depth (feet) <u>243'</u></p> <p>(3) static water level (feet) <u>18</u> <small>below above</small> top of ground.</p> <p>(4) casing <u>PVC</u>, <u>233'</u> (material) (depth)</p> <p><u>2"</u> (size) If telescope see back.</p> <p>(5) screen <u>10'</u>, <u>233'</u> (length) (depth to top)</p> <p><u>2"</u>, <u>PVC</u> (size) (material)</p> <p>(6) pump <u>1</u> <u>15</u> (HP) (yield gpm)</p> <p><u>electric</u> (type power)</p> <p>(7) electric log <u>NO</u> (yes or no)</p> <p><u>NO</u> (organization running log)</p> <p>(8) how well bottom plugged <u>sand</u> <u>shark</u></p>			
<p>DRILLERS REMARKS:</p>			


DEPT. OF NATURAL RESOURCES
 BUREAU OF LAND & WATER RESOURCES

APR 23 1982

RECEIVED

If well telescopes please sketch and show depths.

GROUND LEVEL

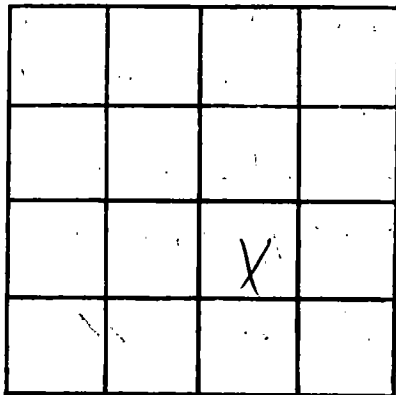

SECTION 18

Please indicate well location X.

ADDITIONAL INFORMATION

If more than one screen, show locations of each on sketch.