

MISSISSIPPI DEPARTMENT OF NATURAL RESOURCES

Bureau of Land and Water Resources

Southport Mall

P.O. Box 10631

Jackson, Mississippi 39209

WATER WELL DRILLERS LOG
COASTAL DRILLING & SERVICE CO.

ROUTE 1 BOX 618
firm name

BILOXI, MISS. 39532

Harrison
county well located

Harrison
L
2041

10/18/83 19
date well completed

LANDOWNER: W.B. Pulliam

description of formations encountered	from to	
<u>Top Soil</u>	<u>1</u>	<u>3</u>
<u>Red Clay</u>	<u>3</u>	<u>18</u>
<u>White Sand</u>	<u>18</u>	<u>40</u>
<u>Soft Blue Clay</u>	<u>40</u>	<u>260</u>
<u>Good Underbank</u>	<u>260</u>	<u>280</u>

2041 ms
(mailing address)

WELL LOCATION:

sec. 16 T 2 N R 11 E
5 W
Highway I 10
(distance) miles (direction) (nearest town)

WELL PURPOSE: home
(home, irrigation, municipal, industrial)

WELL COMPLETION DATA:

- (1) diameter (inches) 2"
- (2) total depth (feet) 280'
- (3) static water level (feet) 40' below top of ground
- (4) casing PVC 270'
(material) (depth)
- (size) If telescope see back.
- (5) screen 10' 270'
(length) (depth to top)
- 2" PVC
(size) (material)
- (6) pump 1/2 12
(HP) (yield gpm)
- 5hp
(type power)
- (7) electric log no
(yes or no)


(organization running log)

(8) how well bottom plugged
2" back with gravel
DRILLERS REMARKS: 19B

JUL - 2 1984
RECEIVED

If well telescopes please sketch and show depths.

GROUND LEVEL

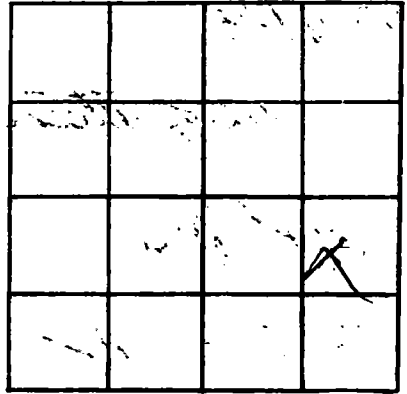

SECTION _____

Please indicate well location X.

ADDITIONAL INFORMATION

If more than one screen, show locations of each on sketch.