

MISSISSIPPI DEPARTMENT OF NATURAL RESOURCES

Bureau of Land and Water Resources

Southport Mall

P.O. Box 10631

Jackson, Mississippi 39209

WATER WELL DRILLERS LOG

COASTAL DRILLING & SERVICE CO.

Harrison  
L  
2043

12/16/83  
 date well completed

ROUTE 1 BOX 618  
 location

Harrison  
 county well located

LANDOWNER: Robert Barcland  
Esq. MRS

BILOXI, MISS. 39532  
 location

description of formations encountered	from	to
<u>topsoil</u>	<u>1</u>	<u>3</u>
<u>Red Clay</u>	<u>3</u>	<u>12</u>
<u>White Sand</u>	<u>12</u>	<u>35</u>
<u>Soft Blue Clay</u>	<u>35</u>	<u>140</u>
<u>fine water sand</u>	<u>140</u>	<u>165</u>
<u>Good water sand</u>	<u>165</u>	<u>190</u>

(mailing address)

WELL LOCATION:

sec. 2d T. 7 N. R. 14 E.  
 S. W.  
Turkey Creek  
 (distance) miles (direction) of (nearest town)

WELL PURPOSE: Water  
 (home, irrigation, municipal, industrial)

WELL COMPLETION DATA:

- (1) diameter (inches) 2"
- (2) total depth (feet) 190'
- (3) static water level (feet) 20' below top of ground.
- (4) casing PVC, 180'  
 (material) (depth)
- (size) If telescope see back.
- (5) screen 10', 180'  
 (length) (depth to top)
- 2"  
 (size) PVC  
 (material)
- (6) pump None, 14  
 (HP) (field gpm)
- Electric  
 (type power)
- (7) electric log No  
 (yes or no)

(organization running log)

(8) how well bottom plugged  
2" hole with gravel  
 DRILLERS REMARKS: 19-15


DEPT. OF NATURAL RESOURCES  
 BUREAU OF LAND & WATER RESOURCES

APR - 6 1984

RECEIVED

If well telescopes please sketch and show depths.

GROUND LEVEL

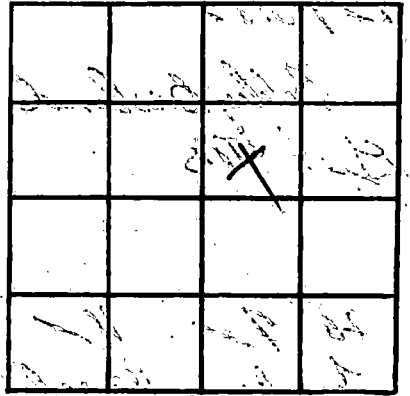

SECTION \_\_\_\_\_

Please indicate well location X.

ADDITIONAL INFORMATION

If more than one screen, show locations of each on sketch.