

MISSISSIPPI DEPARTMENT OF NATURAL RESOURCES

Bureau of Land and Water Resources

Southport Mall

P.O. Box 10631

Jackson, Mississippi 39209

WATER WELL DRILLERS LOG

Harrison
L
2044

date well completed 2-10 1984 firm name McBill Wells, INC county well located HARRISON

LANDOWNER: <u>RDUG GOSSAGE</u> <u>1924 42ND AVE</u> <u>GPT, MS 39501</u> (mailing address)	description of formations encountered	from	to
WELL LOCATION: sec <u>32</u> T <u>7</u> N R <u>11</u> E <u>1/2</u> miles <u>S/W</u> of <u>GPT Airport</u> (distance) (direction) (nearest town)	SAND	0	40
WELL PURPOSE: <u>home</u> (home, irrigation, municipal, industrial)	MUD	40	60
WELL COMPLETION DATA:	SAND	60	100
(1) diameter (Inches) <u>2"</u>	MUD	100	360
(2) total depth (feet) <u>630'</u>	SAND/MUD	360	380
(3) static water level (feet) <u>1</u> below above top of ground.	MUD	380	560
(4) casing <u>sch 40 pipe 610'</u> (material) (depth)	MUD/SAND	560	580
(size) if telescope see back.	SAND	580	630
(5) screen <u>10'</u> <u>610'</u> (length) (depth to top)			
(size) <u>2"</u> <u>sch 80 PVC 6 slot</u> (material)			
(6) pump <u>1</u> <u>15</u> (HP) (yield gpm)			
<u>ELECTRIC</u> (type power)			
(7) electric log <u>ND</u> (yes or no)			
(organization running log)			
(8) how well bottom plugged <u>SAND</u> <u>SEAL</u>			
DRILLERS REMARKS:			


DEPT. OF NATURAL RESOURCES
 BUREAU OF LAND & WATER RESOURCES

MAR - 6 1984

RECEIVED

If well telescopes please sketch and show depths.

GROUND LEVEL

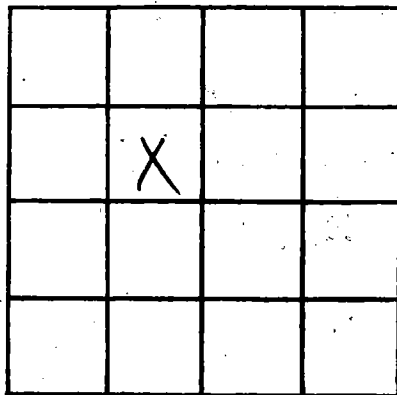

SECTION 32

Please indicate well location X.

ADDITIONAL INFORMATION

If more than one screen, show locations of each on sketch.