

MISSISSIPPI DEPARTMENT OF NATURAL RESOURCES
Bureau of Land and Water Resources
 Southport Mall
 P.O. Box 10631
 Jackson, Mississippi 39209
WATER WELL DRILLERS LOG

Harrison
L
2045

date well completed 2-19-1984 firm name McGill Wells, Inc. county well located HARRISON


LANDOWNER: <u>DEWITT BLAIR</u>	description of formations encountered	from	to
<u>P.O. Box 450</u>	<u>SAND</u>	<u>0</u>	<u>40</u>
<u>GULFPORT MS</u> (mailing address)	<u>MUD</u>	<u>40</u>	<u>200</u>
WELL LOCATION:	<u>SAND</u>	<u>200</u>	<u>210</u>
sec. <u>31</u> T. <u>8</u> N. R. <u>11</u> E.	<u>MUD</u>	<u>210</u>	<u>220</u>
<u>4</u> miles <u>WEST</u> of <u>GULFPORT</u> (distance) (direction) (nearest town)	<u>SAND</u>	<u>220</u>	<u>280</u>
WELL PURPOSE: <u>HOME</u> (home, irrigation, municipal, industrial)			
WELL COMPLETION DATA:			
(1) diameter (inches) <u>2"</u>			
(2) total depth (feet) <u>280'</u>			
(3) static water level (feet) <u>77</u> <u>below</u> top of ground.			
(4) casing <u>40 PVC, 270'</u> (material) (depth)			
_____ If telescope see back. (size)			
(5) screen <u>10'</u> , <u>270'</u> (length) (depth to top)			
<u>2"</u> , <u>80 PVC 1/2 SLOT</u> (size) (material)			
(6) pump <u>1</u> <u>10</u> (HP) (yield gpm)			
<u>Electric</u> (type power)			
(7) electric log <u>NO</u> (yes or no)			
_____ (organization running log)			
(8) how well bottom plugged <u>SAND</u>			
DRILLERS REMARKS:			

DEPT. OF NATURAL RESOURCES
 BUREAU OF LAND & WATER RESOURCES

RECEIVED
 MAR - 6 1984

If well telescopes please sketch and show depths.

GROUND LEVEL

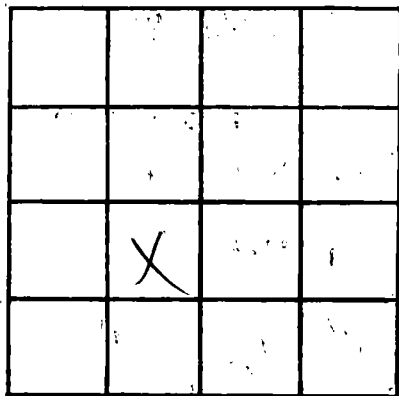

SECTION 31

Please indicate well location X.

ADDITIONAL INFORMATION

If more than one screen, show locations of each on sketch.