

**MISSISSIPPI DEPARTMENT OF NATURAL RESOURCES**  
**Bureau of Land and Water Resources**  
 Southport Mall  
 P.O. Box 10631  
 Jackson, Mississippi 39209  
**WATER WELL DRILLERS LOG**

Harrison  
L  
2048

4/11/84 date well completed    McKie Well Works firm name    Harrison county well located

LANDOWNER: Charles McKieley  
14 Bayou View Dr.  
Southport, Ms.  
 (mailing address)

description of formations encountered	from	to
	<u>Sand</u>	<u>0</u>

WELL LOCATION:  
 sec 32 T 7 S R 11 E  
2 miles N of Southport  
 (distance) (direction) (nearest town)

WELL PURPOSE: Dr.  
 (home, irrigation, municipal, industrial)


- WELL COMPLETION DATA:
- (1) diameter (inches) 2"
  - (2) total depth (feet) 30'
  - (3) static water level (feet) 10 <sup>below</sup> ~~above~~ top of ground.
  - (4) casing sch 40 pipe, 30'  
 (material) (depth)  
 (size) If telescope see back.
  - (5) screen 10', 30'  
 (length) (depth to top)  
2", sch 80  
 (size) (material)
  - (6) pump 1/2, 12  
 (HP) (yield gpm)  
elec.  
 (type power)
  - (7) electric log                       
 (yes or no)  
                      
 (organization running log)
  - (8) how well bottom plugged Cap.

DRILLERS REMARKS:                     

DEPT. OF NATURAL RESOURCES  
 BUREAU OF LAND & WATER RESOURCES  
**RECEIVED**  
 JUN - 1 1984

If well telescopes please sketch and show depths.

GROUND LEVEL

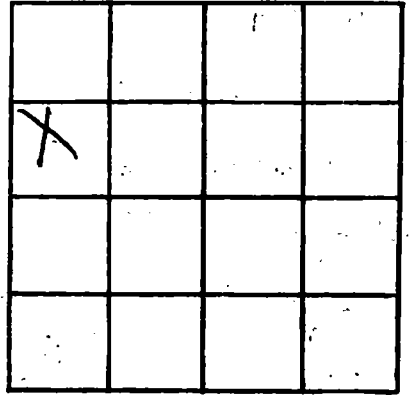

SECTION \_\_\_\_\_

Please indicate well location X.

ADDITIONAL INFORMATION

If more than one screen, show locations of each on sketch.