

MISSISSIPPI DEPARTMENT OF NATURAL RESOURCES  
 Bureau of Land and Water Resources  
 Southport Mall  
 P.O. Box 10631  
 Jackson, Mississippi 39209  
**WATER WELL DRILLERS LOG**

<u>Harrison</u>
<u>V</u>
<u>2049</u>

4-24-84 1984 McNeil Well Works Harrison  
 date well completed      firm name      county well located

LANDOWNER: Pat Worth  
P.O. Box 444  
Wiggins, Mo.  
(mailing address)  
Well in back yard  
 WELL LOCATION:  
 sec. 32 T-7 N R-11 E  
1 miles W of Dept  
(distance) (direction) (nearest town)

description of formations encountered	from	to
	<u>Sand</u>	<u>0</u>
<u>mud</u>	<u>160</u>	<u>160</u>
<u>Sand</u>	<u>160</u>	<u>190</u>

WELL PURPOSE:  
(home, irrigation, municipal, industrial)

WELL COMPLETION DATA:

(1) diameter (inches) 2"

(2) total depth (feet) 300'

(3) static water level (feet) 160 below above  
top of ground.

(4) casing sch 40 PVC, 190'  
(material) (depth)

(size) If telescope see back.

(5) screen 10', 190'  
(length) (depth to top)

2", sch 80  
(size) (material)

(6) pump 1 9  
(HP) (yield gpm)

elec.  
(type power)

(7) electric log —  
(yes or no)

(organization running log)

(8) how well bottom plugged good seal

DRILLERS REMARKS:


DEPT. OF NATURAL RESOURCES  
 BUREAU OF LAND & WATER RESOURCES

JUN - 1 1984

**RECEIVED**

If well telescopes please sketch and show depths.

GROUND LEVEL

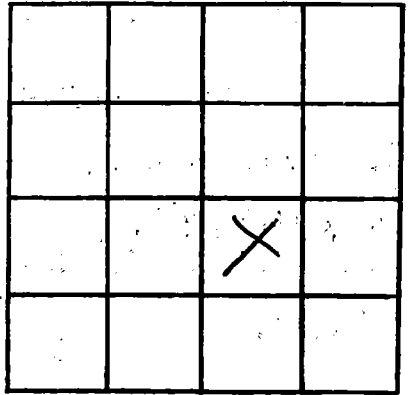

SECTION \_\_\_\_\_

Please indicate well location X.

ADDITIONAL INFORMATION

If more than one screen, show locations of each on sketch.