

MISSISSIPPI DEPARTMENT OF NATURAL RESOURCES
Bureau of Land and Water Resources
 Southport Mall
 P.O. Box 10631
 Jackson, Mississippi 39209
WATER WELL DRILLERS LOG

L 2051

6-7-84 19
 date well completed

McGill Well Works
 firm name

Harrison
 county well located

LANDOWNER: Springsted
609 Sawyer
Guyton, Mo.
 (mailing address)

| description of formations encountered | from | to |
|---------------------------------------|----------|-----------|
| <u>Sand</u> | <u>0</u> | <u>20</u> |

WELL LOCATION:
 sec 32 T N R 11 E
6 miles S of Guyton
 (distance) (direction) (nearest town)

WELL PURPOSE:
 (home, ~~irrigation~~, municipal, industrial)

- WELL COMPLETION DATA:**
- (1) diameter (inches) 2"
 - (2) total depth (feet) 20'
 - (3) static water level (feet) 6" below top of ground
 - (4) casing sch 40, 10'
 (material) (depth)
 - _____ If telescope see back.
 (size)
 - (5) screen 10', 10'
 (length) (depth to top)
2", sch 40
 (size) (material)
 - (6) pump 1/2, 8
 (HP) (yield gpm)
elec
 (type power)
 - (7) electric log _____
 (yes or no)

 (organization running log)
 - (8) how well bottom plugged Cap

DEPT. OF NATURAL RESOURCES
 BUREAU OF LAND & WATER RESOURCES


JUL 10 1984

RECEIVED

DRILLERS REMARKS:

If well telescopes please sketch and show depths.

GROUND LEVEL

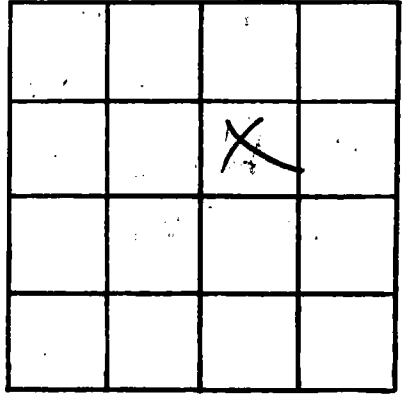

SECTION 32

Please indicate well location X.

ADDITIONAL INFORMATION

If more than one screen,
show locations of each on sketch.