

MISSISSIPPI DEPARTMENT OF NATURAL RESOURCES

Bureau of Land and Water Resources

Southport Mall

P.O. Box 10631

Jackson, Mississippi 39209

WATER WELL DRILLERS LOG

COASTAL DRILLING & SERVICE CO.

Hansen  
L  
2054

8/1/83 19  
date well completed

ROUTE 1 BOX 618  
mailing address

Hansen  
county well located

Landowner: Dickson  
MS  
apt 145 London Road  
(mailing address)

BILOXI, MISS. 39532

description of formations encountered

from to

<u>Top Soil</u>	<u>1</u>	<u>3</u>
<u>Red Clay</u>	<u>3</u>	<u>15</u>
<u>Sand. Soil</u>	<u>15</u>	<u>30</u>
<u>Soft Blue Clay</u>	<u>30</u>	<u>230</u>
<u>Hard Blue Clay</u>	<u>230</u>	<u>300</u>
<u>Soft Water Sand</u>	<u>300</u>	<u>320</u>

WELL LOCATION:

sec. 7 T. 7 N. R. 11 E  
S W  
New Hope  
(distance) (direction) of (nearest town)

WELL PURPOSE:

(home, irrigation, municipal, industrial)

WELL COMPLETION DATA:

- (1) diameter (inches) 2"
- (2) total depth (feet) 320'
- (3) static water level (feet) 60' below above top of ground.
- (4) casing PVC 310'  
(material) (depth)  
(size) if telescope see back.
- (5) screen 10' 310'  
(length) (depth to top)  
2" PVC  
(size) (material)
- (6) pump Stone 10  
(HP) (yield gpm)  
Electric  
(type power)
- (7) electric log no  
(yes or no)

(organization running log)

(8) how well bottom plugged  
2" back wash valve

DRILLERS REMARKS: 19-8

DEPT. OF NATURAL RESOURCES  
BUREAU OF LAND & WATER RESOURCES

JUN 28 1984


RECEIVED

If well telescopes please sketch and show depths.

GROUND LEVEL

*Handwritten notes on the left side of the page, including numbers and symbols.*

*Handwritten notes in the middle section, possibly describing well details or observations.*

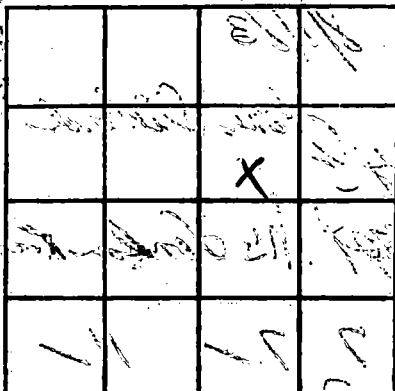

*Handwritten text below the grid, possibly 'Well location'.*

SECTION \_\_\_\_\_

Please indicate well location X.

ADDITIONAL INFORMATION

Series of horizontal lines for recording additional information, with some faint handwritten notes.

If more than one screen, show locations of each on sketch.