

MISSISSIPPI DEPARTMENT OF NATURAL RESOURCES

Bureau of Land and Water Resources

Southport Mall

P.O. Box 10631

Jackson, Mississippi 39209

WATER WELL DRILLERS LOG

COASTAL DRILLING & SERVICE CO.

Harrison  
L  
2055

9/16/83  
date well completed

ROUTE 6 BOX 618

Harrison  
county well located

LANDOWNER

Paul A. Hale

MISS. 39532  
description of formations encountered

from to

Rt 6

Top Soil

1 3

apt 115  
(mailing address)

Red Clay

3 15

WELL LOCATION:

sec. 17 T 2 N R. 11 E W

Soft Red Clay

15 30

London  
(distance) miles (direction) of (nearest town)

Gravel Sand

30 45

WELL PURPOSE: Home  
(home, irrigation, municipal, industrial)

WELL COMPLETION DATA:

- (1) diameter (inches) 2"
- (2) total depth (feet) 480'
- (3) static water level (feet) 357 below above top of ground.

Soft Blue Clay

45 215

Hard Blue Clay

215 420

Fire water Sand

420 450

Gravel Water Sand

450 480

- (4) casing PVC, 470'  
(material) (depth)

(size) if telescope see back.

- (5) screen 10', 470'  
(length) (depth to top)

2", PVC  
(size) (material)

- (6) pump None, 12  
(HP) (yield gpm)

5hp  
(type power)

- (7) electric log no  
(yes or no)

(organization running log)

- (8) how well bottom plugged

2" pack wash valve  
DRILLERS REMARKS: 14-15


DEPT. OF NATURAL RESOURCES  
BUREAU OF LAND & WATER RESOURCES

JUN 29 1984

RECEIVED

If well telescopes please sketch and show depths.

GROUND LEVEL

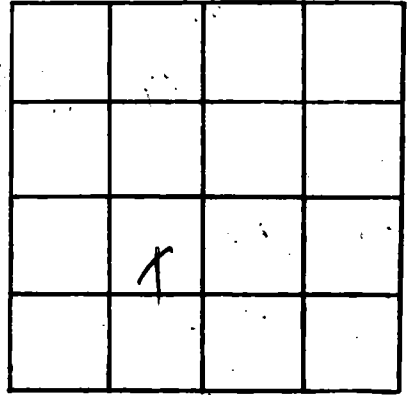

SECTION \_\_\_\_\_

Please indicate well location X.

ADDITIONAL INFORMATION

If more than one screen, show locations of each on sketch.