

MISSISSIPPI DEPARTMENT OF NATURAL RESOURCES

Bureau of Land and Water Resources

Southport Mall

P.O. Box 10631

Jackson, Mississippi 39209

WATER WELL DRILLERS LOG

HARRISON  
L 2062

7-1-84

date well completed

19 McDiell Wood Harrison

firm name

county well located

LANDOWNER: Richard Jaffe

description of formations encountered

from

to

308 Harris Dr.

Bullport, Ms. 39503  
(mailing address)

WELL LOCATION:

sec 32 T 7 N R 11 E W  
6 miles S of Gpt  
(distance) (direction) (nearest town)

WELL PURPOSE:

(home, irrigation, municipal, industrial)

WELL COMPLETION DATA:

- (1) diameter (inches) 2"
- (2) total depth (feet) 420'
- (3) static water level (feet) 60' below top of ground
- (4) casing (material) 4" sch 40 PVC, (depth) 410'

(size) If telescope see back.

- (5) screen 10' (length), 410' (depth to top)  
2" sch 80 PVC (size) (material)

- (6) pump 1 (HP), 9 (yield gpm)

elec (type power)

- (7) electric log (yes or no)

(organization running log)

- (8) how well bottom plugged Sand Seal

Mud	0	20
Sand	20	40
Mud	40	60
Mud & Sand	60	80
Sand	80	140
Mud & Sand	140	160
Sand	160	180
Mud & Sand	180	240
Sand	240	260
Sand	260	280
Mud	280	420

DRILLERS REMARKS:


DEPT. OF NATURAL RESOURCES  
BUREAU OF LAND & WATER RESOURCES

JUL 10 1984

RECEIVED

If well telescopes please sketch and show depths.

GROUND LEVEL

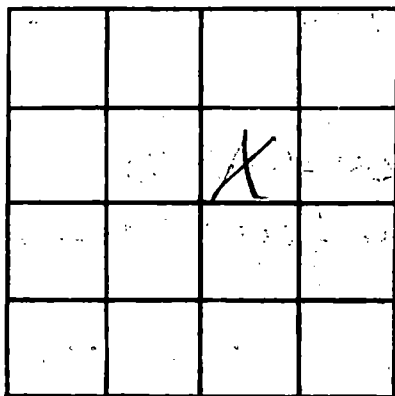

SECTION 32

Please indicate well location X.

ADDITIONAL INFORMATION

Lined area for additional information.

If more than one screen, show locations of each on sketch.