

MISSISSIPPI DEPARTMENT OF NATURAL RESOURCES

Bureau of Land and Water Resources

Southport Mall

P.O. Box 10631

Jackson, Mississippi 39209

WATER WELL DRILLERS LOG

Harrison  
L  
2064

7-12-84 19 Mediac Well Works Harrison  
 date well completed firm name county well located

LANDOWNER: Beck Welch  
College Park  
Duport, Mo  
 (mailing address)

description of formations encountered	from	to
<u>Sand</u>	<u>0</u>	<u>30</u>

WELL LOCATION:  
 sec 32 T 7 N R 11 E  
5 miles E of Duport  
 (distance) (direction) (nearest town)

WELL PURPOSE:  
 (home, irrigation, municipal, industrial)

- WELL COMPLETION DATA:
- (1) diameter (inches) 2"
  - (2) total depth (feet) 30'
  - (3) static water level (feet) 20' below above top of ground.
  - (4) casing Sch 40 PVC 20'  
 (material) (depth)  
 (size) if telescope see back.
  - (5) screen 10' 20'  
 (length) (depth to top)  
2" Sch 40 PVC  
 (size) (material)
  - (6) pump 1/2 13  
 (HP) (yield gpm)  
elec  
 (type power)
  - (7) electric log         
 (yes or no)  
 (organization running log)
  - (8) how well bottom plugged cap

DEPT. OF NATURAL RESOURCES  
 BUREAU OF LAND & WATER RESOURCES


AUG 13 1984

RECEIVED

DRILLERS REMARKS: \_\_\_\_\_

If well telescopes please sketch and show depths.

GROUND LEVEL

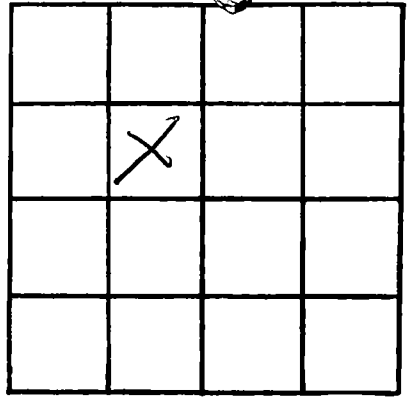

SECTION \_\_\_\_\_

Please indicate well location X.

ADDITIONAL INFORMATION

If more than one screen,  
show locations of each on sketch.