

MISSISSIPPI DEPARTMENT OF NATURAL RESOURCES

Bureau of Land and Water Resources

Southport Mall

P.O. Box 10631

Jackson, Mississippi 39209

WATER WELL DRILLERS LOG

Harrison  
L 2065

11/27/84 19  
date well completed

Lyman Well Co Harrison  
firm name county well located

LANDOWNER: Cleanor Tharles  
Rt. 1, Box 171  
Gulfport, Md 39503  
(mailing address)

description of formations encountered	from	to
<u>yellow sand yellow clay</u>	<u>0</u>	<u>100</u>
<u>Blue clay</u>	<u>100</u>	<u>194</u>
<u>Blue clay fine sand</u>	<u>194</u>	<u>290</u>
<u>Blue clay</u>	<u>290</u>	<u>373</u>
<u>Coarse sand</u>	<u>373</u>	<u>400</u>

WELL LOCATION:

sec. 18 T. 7 N. R. 11 E  
7 miles N of GPT  
(distance) (direction) (nearest town)

WELL PURPOSE: Home  
(home, irrigation, municipal, industrial)

WELL COMPLETION DATA:

- (1) diameter (inches) 2"
- (2) total depth (feet) 400'
- (3) static water level (feet) 50 below top of ground.
- (4) casing PVC, 390'  
(material) (depth)  
2" if telescope see back.  
(size)
- (5) screen 10', 390'  
(length) (depth to top)  
2" PVC  
(size) (material)
- (6) pump 1 12  
(HP) (yield gpm)  
electric  
(type power)
- (7) electric log NO  
(yes or no)  
NO  
(organization running log)
- (8) how well bottom plugged sand shark

DRILLERS REMARKS:


DEPT. OF NATURAL RESOURCES  
BUREAU OF LAND & WATER RESOURCES

SEP - 5 1984

RECEIVED

If well telescopes please sketch and show depths.

GROUND LEVEL

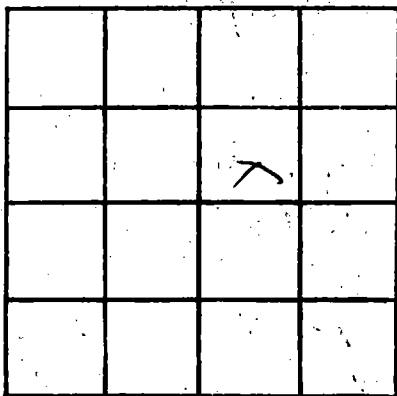

SECTION 18

Please indicate well location X.

ADDITIONAL INFORMATION

If more than one screen, show locations of each on sketch.