

MISSISSIPPI DEPARTMENT OF NATURAL RESOURCES

Bureau of Land and Water Resources

Southport Mall

P.O. Box 10631

Jackson, Mississippi 39209

WATER WELL DRILLERS LOG

Harrison
L 2070

10-22-84

date well completed

19 Mc Mill Well Works

firm name

Harrison

county well located

LANDOWNER: Super B Const.

description of formations encountered


from

to

Red Creek Estates
Hong Beach, Ms.
 (mailing address)

Sand	0	20
Sand & mud	20	40
mud	40	80
mud & sand	80	100
sand	100	120
mud	120	180
mud & sand	180	200
mud	200	230
mud & sand	230	240
mud	240	260
mud & sand	260	300
mud	300	340
mud & sand	340	360
mud	360	380
mud	380	400
sand	400	440

WELL LOCATION:

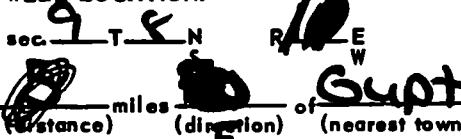

WELL PURPOSE:

(home, irrigation, municipal, industrial)

Home

WELL COMPLETION DATA:

- (1) diameter (inches) 2'
- (2) total depth (feet) 440'
- (3) static water level (feet) 30' ^{below} top of ground. 3 1/2' ^{above}
- (4) casing sch 40 (material) 430' (depth)
- (5) screen 10' (length) 430' (depth to top)
2" (size) sch 40 6 slot (material)
- (6) pump 1 (HP) 9 (yield gpm)
elec (type power)
- (7) electric log — (yes or no)
— (organization running log)
- (8) how well bottom plugged Seal

DEPT. OF NATURAL RESOURCES
 BUREAU OF LAND & WATER RESOURCES


DEC - 3 1984

RECEIVED

DRILLERS REMARKS:

If well telescopes please sketch and show depths.

GROUND LEVEL

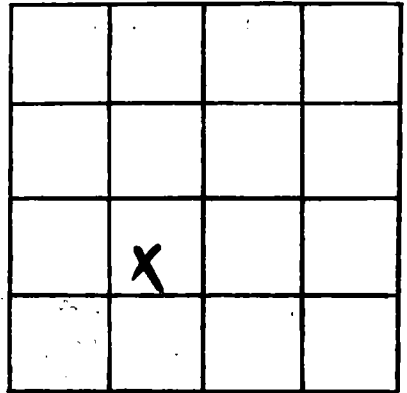

SECTION _____

Please indicate well location X.

ADDITIONAL INFORMATION

If more than one screen,
show locations of each on sketch.