

MISSISSIPPI DEPARTMENT OF NATURAL RESOURCES

Bureau of Land and Water Resources

Southport Mall

P.O. Box 10631

Jackson, Mississippi 39209

WATER WELL DRILLERS LOG

Harrison
L
2073

9-27-84
date well completed

McKee Well Works
firm name

Harrison
county well located

LANDOWNER:

Mrs. Hancock

description of formations encountered

from

to

Yankee town Rd.

mud	0	120
mud sand	120	140
mud	140	220
mud sand	220	240
sand	240	280

Saucier, Ms.
(mailing address)

WELL LOCATION:

sec. 3 T 2 N R 11 E
7 S W
3 miles N of Gupt
(distance) (direction) (nearest town)

WELL PURPOSE:

home, irrigation, municipal, industrial

WELL COMPLETION DATA:

- (1) diameter (inches) 2"
- (2) total depth (feet) 280'
- (3) static water level (feet) 15' below top of ground
- (4) casing 2" PVC, 220'
(material) (depth)
(size) if telescope see back.
- (5) screen 10' 2" 270'
(length) (depth to top)
(size) 2" screen slot
(material)
- (6) pump 1 10
(HP) (yield gpm)
elec.
(type power)
- (7) electric log (yes or no)
- (organization running log)
- (8) how well bottom plugged Seal

DEPT. OF NATURAL RESOURCES
BUREAU OF LAND & WATER RESOURCES


DEC - 3 1984

RECEIVED

DRILLERS REMARKS:

If well telescopes please sketch and show depths.

GROUND LEVEL

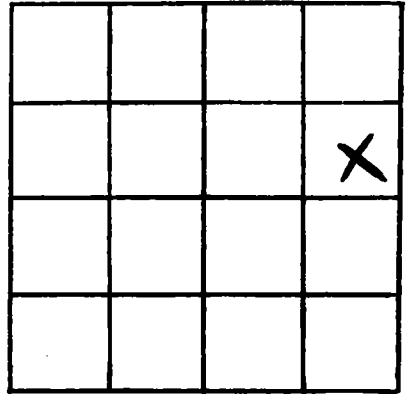

SECTION _____

Please indicate well location X.

ADDITIONAL INFORMATION

If more than one screen,
show locations of each on sketch.