

**MISSISSIPPI DEPARTMENT OF NATURAL RESOURCES**  
**Bureau of Land and Water Resources**  
 Southport Mall  
 P.O. Box 10631  
 Jackson, Mississippi 39209  
**WATER WELL DRILLERS LOG**

Harrison  
L  
2075

8/28/84 19 Lyman Well Co. Harrison  
 date well completed firm name county well located

LANDOWNERS	description of formations encountered	from	to
<u>Roger Buckley</u>	<u>top soil</u>	<u>0</u>	<u>3</u>
<u>Rt. 1, Box 87</u>	<u>yellow clay</u>	<u>3</u>	<u>12</u>
<u>Gulfport, Md 39503</u> (mailing address)	<u>white sand</u>	<u>12</u>	<u>25</u>
<b>WELL LOCATION:</b>	<u>gray clay</u>	<u>25</u>	<u>55</u>
sec. <u>17</u> T. <u>7</u> N. R. <u>11</u> E.	<u>blue clay</u>	<u>55</u>	<u>160</u>
<u>3</u> miles <u>NW</u> of <u>Spt</u>	<u>sand</u>	<u>160</u>	<u>215</u>
(distance) (direction) (nearest town)			
<b>WELL PURPOSE:</b> <u>home</u>			
(home, irrigation, municipal, industrial)			

**WELL COMPLETION DATA:**

(1) diameter (inches) 4 X 2

(2) total depth (feet) 215'

(3) static water level (feet) 20 below above  
 top of ground.

(4) casing PVC, 195'  
 (material) (depth)

4"  
 (size) if telescope see back.

(5) screen 20', 195'  
 (length) (depth to top)

2", PVC  
 (size) (material)

(6) pump 1, 30  
 (HP) (yield gpm)

electric  
 (type power)

(7) electric log NO  
 (yes or no)

NO  
 (organization running log)

(8) how well bottom plugged sand  
shark

DEPT. OF NATURAL RESOURCES  
 BUREAU OF LAND & WATER RESOURCES


DEC 17 1984

**RECEIVED**

DRILLERS REMARKS:

If well telescopes please sketch and show depths.

GROUND LEVEL

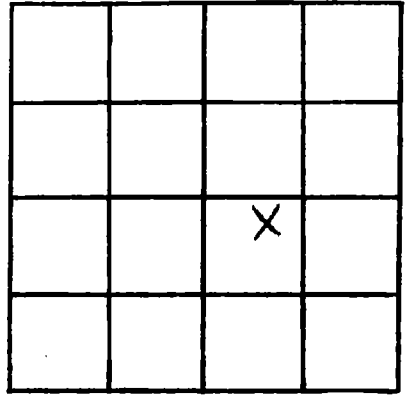

SECTION 17

Please indicate well location X.

ADDITIONAL INFORMATION

If more than one screen, show locations of each on sketch.