

MISSISSIPPI DEPARTMENT OF NATURAL RESOURCES

Bureau of Land and Water Resources

Southport Mall

P.O. Box 10631

Jackson, Mississippi 39209

WATER WELL DRILLERS LOG

COASTAL DRILLING & SERVICE CO.

HARRISON
L 2080
4/11/85

4/11/85
date well completed

RT 11, BOX 81
firm name

BLOXI, MS 39532

Harrison
county well located

LANDOWNER: Nick Foto
South Swan Rd
Hwy 90, MS
(mailing address)

| description of formations encountered | from | to |
|---------------------------------------|------|-----|
| top soil | 1 | 10 |
| sugar sand | 10 | 25 |
| red clay | 25 | 190 |
| soft blue clay | 190 | 380 |
| hard blue clay | 380 | 460 |
| fine water sand | 460 | 470 |
| good water sand | 470 | 480 |

WELL LOCATION:
sec. 33 T 7 N R 11 E
S W
0.1 miles of
(distance) (direction) (nearest town)

WELL PURPOSE: home
(home, irrigation, municipal, industrial)

- WELL COMPLETION DATA:
- (1) diameter (inches) 4" x 2"
 - (2) total depth (feet) 480
 - (3) static water level (feet) 10 below top of ground
 - (4) casing PVC, 405, (material) (depth)
4" x 12" (size) if telescope see back.
 - (5) screen 15, 405 (length) (depth to top)
2" PVC (size) (material)
 - (6) pump 1/2, 17 (HP) (yield gpm)
ELC (type power)
 - (7) electric log No (yes or no)
(organization running log)
 - (8) how well bottom plugged 2" back
wash pipe

DRILLERS REMARKS:

RECEIVED
AUG 27 1985

Department of Natural Resources
Bureau of Land & Water Resources

If well telescopes please sketch and show depths.


GROUND LEVEL

200 4" pvc casing

280' 2" pvc casing

15' 2" pvc screen

2" back wash valve

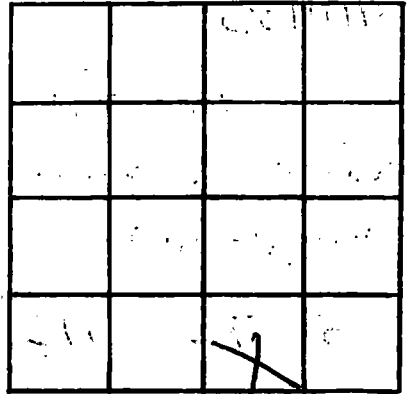

SECTION _____

Please indicate well location X.

ADDITIONAL INFORMATION

If more than one screen, show locations of each on sketch.