

MISSISSIPPI DEPARTMENT OF NATURAL RESOURCES

Bureau of Land and Water Resources

Southport Mall

P.O. Box 10631

Jackson, Mississippi 39209

WATER WELL DRILLERS LOG

HARRISON
L 2088

6/4/85, 19 Lipman Well Harrison
date well completed firm name county well located

LANDOWNER: J. L. Beech
245 Holland Ave.
Jackson, MS
(mailing address)

description of formations encountered	from	to
White Clay White Clay	0	60
Blue clay	60	203
SAND CORSE	203	243

WELL LOCATION:
sec. 15 T. 7 N R. 11 E
8 miles East of ~~Southport~~
(distance) (direction) (nearest town)

WELL PURPOSE: DRY
(home, irrigation, municipal, industrial)

- WELL COMPLETION DATA:
- (1) diameter (inches) 2"
 - (2) total depth (feet) 253'
 - (3) static water level (feet) 3' below above top of ground.
 - (4) casing PVC 243'
(material) (depth)
2"
(size) if telescope see back.
 - (5) screen 10' 243'
(length) (depth to top)
2" PVC
(size) (material)
 - (6) pump 1/2 10
(HP) (yield gpm)
electric
(type power)
 - (7) electric log No
(yes or no)
No
(organization running log)
 - (8) how well bottom plugged sand shark


RECEIVED
AUG 20 1985

Department of Natural Resources
Bureau of Land & Water Resources

DRILLERS REMARKS:

If well telescopes please sketch and show depths.

GROUND LEVEL

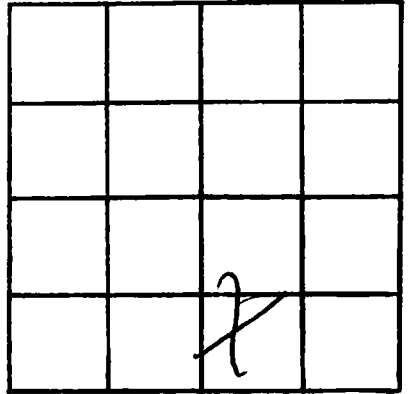

SECTION 15

Please indicate well location X.

ADDITIONAL INFORMATION

If more than one screen, show locations of each on sketch.