

MISSISSIPPI DEPARTMENT OF NATURAL RESOURCES

Bureau of Land and Water Resources

Southport Mall

P.O. Box 10631

Jackson, Mississippi 39209

WATER WELL DRILLERS LOG
COASTAL DRILLING & SERVICE CO.

RT. 11, BOX 81
firm name

DIXON, MS 39532

Harrison
county well located

Harrison
L 2089
9-18-84

9/18/84
date well completed

LANDOWNER: H.M. Daniels, Sr.

300 Pineville Rd.
Dong Beach, MS
(mailing address)

WELL LOCATION:

sec. 14 T. 7 N. R. 11 E.
S W

Dong Beach
(distance) miles (direction) of (nearest town)

WELL PURPOSE:

HOME
(home, irrigation, municipal, industrial)

WELL COMPLETION DATA:

- (1) diameter (inches) 4" x 2"
- (2) total depth (feet) 630'
- (3) static water level (feet) 15' below top of ground.
- (4) casing PVC, 615, 4" x 2" (material) (depth) (size) If telescope see back.
- (5) screen 15', 615, 2" (length) (depth to top) (size) PVC (material)
- (6) pump 1 (HP) 12012 (yield gpm) EIC (type power)
- (7) electric log NO (yes or no)

(organization running log)

- (8) how well bottom plugged 2" back wash valve 19-8

DRILLERS REMARKS:

description of formations encountered	from	to
top soil	1	3
sugar sand	3	40
red clay	40	180
course white sand	180	220
soft blue clay	220	360
course white sand	360	450
hard blue clay	450	600
blue water sand	600	620
good water sand	620	630

RECEIVED

AUG - 2 1985

Department of Natural Resources
Bureau of Land & Water Resources

If well telescopes please sketch and show depths.

GROUND LEVEL


160' 4" pvc casing

470 2" pvc casing

15' 2" pvc screen

2" back wash valve

If more than one screen, show locations of each on sketch.

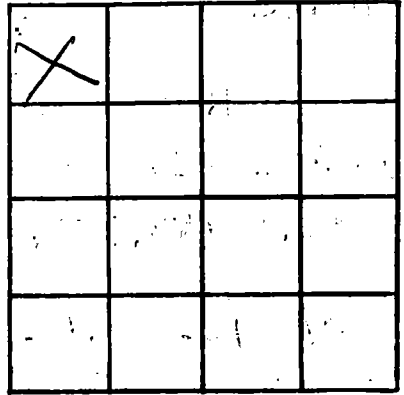

SECTION _____

Please indicate well location X.

ADDITIONAL INFORMATION

Multiple horizontal lines for additional information.