

MISSISSIPPI DEPARTMENT OF NATURAL RESOURCES

Bureau of Land and Water Resources

Southport Mall

P.O. Box 10631

Jackson, Mississippi 39209

WATER WELL DRILLERS LOG  
 COASTAL DRILLING & SERVICE CO.

Harrison  
 L2090  
 1-22-85

11/22/85 19  
 date well completed

RT. 11, BOX 81  
 firm name  
 BILOXI, MS 39532

Harrison  
 county well located

LANDOWNER: Carl Degett  
 Builder

description of formations encountered

from to

309 mayberry st.

top soil

1 3

seige sand

5 15

red clay

15 460

light blue clay

160 280

red blue clay

280 340

fine water sand

340 350

red clay

350 440

fine water sand

450 450

good water sand

450 460

Southport ms  
 (mailing address)

WELL LOCATION:

sec. 35 T. 2 N. R. 10 E  
 S W

Southport (distance) miles of (direction) of (nearest town)

WELL PURPOSE: home  
 (home, irrigation, municipal, industrial)

WELL COMPLETION DATA:

- (1) diameter (inches) 4" x 2"
- (2) total depth (feet) 460
- (3) static water level (feet) 15 below top of ground.

(4) casing PVC 445  
 (material) (depth)

4" x 2" (size) If telescope see back.

(5) screen 15' 445  
 (length) (depth to top)

2" (size) PVC (material)

(6) pump 1 (HP) 10 (yield gpm)

FIC (type power)

(7) electric log NO (yes or no)

(organization running log)

(8) how well bottom plugged 2" back wash valve 1A-B

DRILLERS REMARKS:

RECEIVED  
 JUL 2 1985

Department of Natural Resources  
 Bureau of Land and Water Resources

If well telescopes please sketch and show depths.


GROUND LEVEL

160' 4" pvc casing

300' 2" pvc casing

15' 2" pvc screen

2" back wash valve

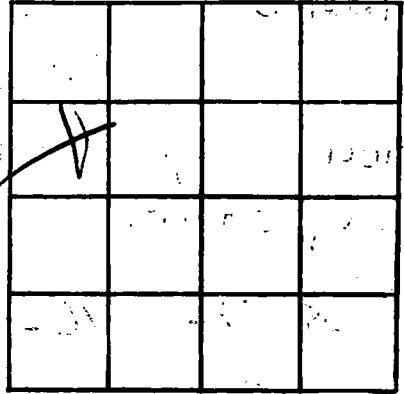

SECTION \_\_\_\_\_

Please indicate well location X.

ADDITIONAL INFORMATION

If more than one screen, show locations of each on sketch.