

HARRISON  
L  
2093

MISSISSIPPI DEPARTMENT OF NATURAL RESOURCES  
Bureau of Land and Water Resources  
Southport Mall  
P.O. Box 10631  
Jackson, Mississippi 39209  
WATER WELL DRILLERS LOG

6-27-85  
date well completed

Mc Hill Pump & Well  
firm name

Harrison  
county well located

LANDOWNER: Mr. Sullivan  
3900 - 16<sup>th</sup> St.  
Southport, Ms. 39501  
(mailing address)

WELL LOCATION:  
sec. 2 T. 7 N. R. 11 E.  
8 miles NE of Southport  
(distance) (direction) (nearest town)

WELL PURPOSE:  
(home, irrigation, municipal, industrial)

WELL COMPLETION DATA: 300' of 4"  
(1) diameter (inches) 4 1/2 300' of 2"  
(2) total depth (feet) 500'  
(3) static water level (feet) 80' below above  
top of ground.  
(4) casing Sch. 40 PVC, 490'  
(material) (depth)  
10' If telescope see back.  
(size)  
(5) screen 10' 490'  
(length) (depth to top)  
2" Sch. 80-60 lb PVC  
(size) (material)  
(6) pump 1 15  
(HP) (yield gpm)  
Elec.  
(type power)  
(7) electric log \_\_\_\_\_  
(yes or no)  
(organization running log)  
(8) how well bottom plugged SAND  
SHARK

description of formations encountered	from	to
Mud / Sand	0	20
Sand / mud	20	40
Mud	40	240
Mud / Sand	240	260
Mud	260	360
Mud / Sand	360	380
Mud	380	400
Mud / Sand	400	420
Sand	420	500


RECEIVED  
JUL 8 - 1985

Department of Natural Resources  
Bureau of Land & Water Resources

DRILLERS REMARKS:

If well telescopes please sketch and show depths.

GROUND LEVEL

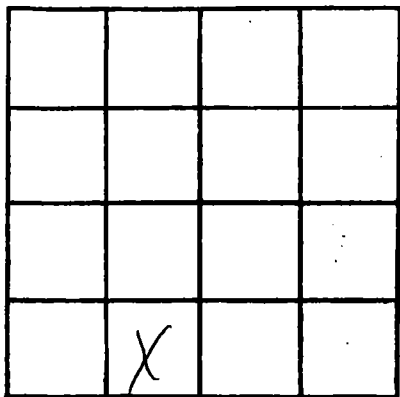

SECTION \_\_\_\_\_

Please indicate well location X.

ADDITIONAL INFORMATION

If more than one screen,  
show locations of each on sketch.