

MISSISSIPPI DEPARTMENT OF NATURAL RESOURCES

Bureau of Land and Water Resources

Southport Mall

P.O. Box 10631

Jackson, Mississippi 39209

WATER WELL DRILLERS LOG

L 2096  
 HARRISON  
 9-20-85

9-20-85 19  
 date well completed

R. J. Mocke  
 firm name

HARRISON  
 county well located

LANDOWNER: JAMES E. NOLAN

ROBINSON RD

COLEPORT, MS

(mailing address)

WELL LOCATION:

sec. 6 T-7 N R-11 E  
 (S) (N)

2 1/2 miles W of NOLAN  
 (distance) (direction) (nearest town)

WELL PURPOSE:

(home, irrigation, municipal, industrial)

WELL COMPLETION DATA:

- (1) diameter (inches) 2"
- (2) total depth (feet) 600'
- (3) static water level (feet) 58' below above top of ground.

(4) casing Pvc, 600  
 (material) (depth)

(size) if telescope see back.

(5) screen 16', 600  
 (length) (depth to top)

2", Pvc  
 (size) (material)

(6) pump 1, 8  
 (HP) (yield gpm)

E  
 (type power)

(7) electric log yes or no

(organization running log)


(8) how well bottom plugged BW the

description of formations encountered

from to

TOP SOIL	0	10
White & Red Clay	10	80
Blue Clay	80	160
Thin Silt & S	160	200
Blue Clay	200	520
Med GRAY Silt & S	520	560
Coarse Silts & S	560	600


DRILLERS REMARKS:

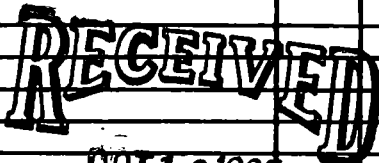

Department of Natural Resources  
 Bureau of Land & Water Resources

If well telescopes please sketch and show depths.

GROUND LEVEL

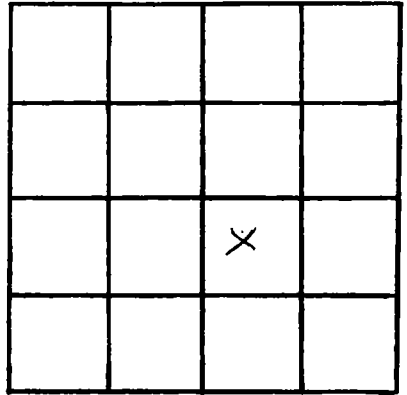

SECTION 6

Please indicate well location X.

ADDITIONAL INFORMATION

If more than one screen, show locations of each on sketch.