

MISSISSIPPI DEPARTMENT OF NATURAL RESOURCES

Bureau of Land and Water Resources

Southport Mall

P.O. Box 10631

Jackson, Mississippi 39209

WATER WELL DRILLERS LOG

HARRISON
L
2097

9-18 1985
date well completed

McHill Pumpwell
firm name

Harrison
county well located

LANDOWNER: Carl McHill
Rt. 1 Box 1580
Shelfport, Ms 39503
(mailing address)

WELL LOCATION:
sec. 30 T. 7 N. R. 11 E.
4 miles NW of Shelfport
(distance) (direction) (nearest town)

description of formations encountered	from	to
Sand	0	80
Mud	80	170
Sand	170	190
Mud	190	240
Sand	240	280

WELL PURPOSE:
(home, irrigation, municipal, industrial)

WELL COMPLETION DATA:

(1) diameter (inches) 2"

(2) total depth (feet) 280'

(3) static water level (feet) 50' below top of ground. above

(4) casing Sch. 40 PVC, 270'
(material) (depth)

 if telescope see back.
(size)

(5) screen 10' 270'
(length) (depth to top)

2" Sch. 80 PVC-620t
(size) (material)

(6) pump 1 9
(HP) (yield gpm)

Elec.
(type power)

(7) electric log
(yes or no)

(organization running log)

(8) how well bottom plugged SAND
SHARK


RECEIVED
NOV 26 1985

DRILLERS REMARKS:

Department of Natural Resources
Bureau of Land & Water Resources

If well telescopes please sketch and show depths.

GROUND LEVEL

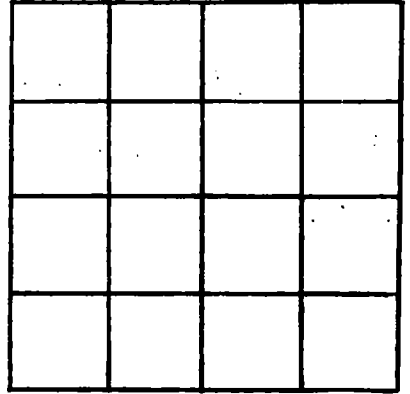

SECTION _____

Please indicate well location X.

ADDITIONAL INFORMATION

If more than one screen, show locations of each on sketch.