

MISSISSIPPI DEPARTMENT OF NATURAL RESOURCES

Bureau of Land and Water Resources

Southport Mall

P.O. Box 10631

Jackson, Mississippi 39209

WATER WELL DRILLERS LOG

HARRISON
L2102

10/4/85 19 Lyman Well Co. Harrison
date well completed firm name county well located

LANDOWNER: Linda Puckett
Rt. 11, Box 350
Gulfport, 39503
(mailing address)

description of formations encountered	from	to
<u>sand & gravel</u>	<u>0</u>	<u>40</u>
<u>white clay</u>	<u>40</u>	<u>80</u>
<u>blue clay</u>	<u>80</u>	<u>160</u>
<u>fine sand</u>	<u>160</u>	<u>180</u>
<u>course sand</u>	<u>180</u>	<u>193</u>

WELL LOCATION:
sec. 11 T. 7 N. R. 11 E.
7 miles N of Gpts
(distance) (direction) (nearest town)

WELL PURPOSE: home
(home, irrigation, municipal, industrial)

WELL COMPLETION DATA:

- (1) diameter (inches) 2"
- (2) total depth (feet) 193'
- (3) static water level (feet) 30' below top of ground above
- (4) casing PVC, 183'
(material) (depth)
2" If telescope see back.
(size)
- (5) screen 10', 183'
(length) (depth to top)
2" PVC
(size) (material)
- (6) pump N/A
(HP) (yield gpm)
(type power)
- (7) electric log No
(yes or no)
No
(organization running log)
- (8) how well bottom plugged sand
shark


DRILLERS REMARKS:

RECEIVED
APR - 9 1986

Department of Natural Resources
Bureau of Land and Water Resources

If well telescopes please sketch and show depths.

GROUND LEVEL

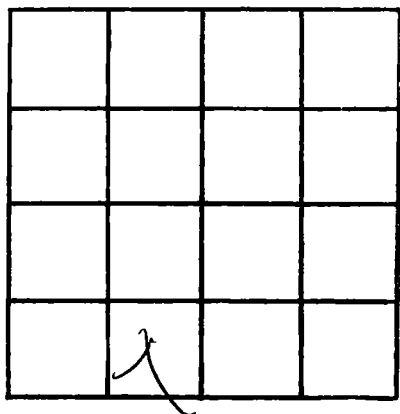

SECTION 11

Please indicate well location X.

ADDITIONAL INFORMATION

If more than one screen, show locations of each on sketch.