

MISSISSIPPI DEPARTMENT OF NATURAL RESOURCES

Bureau of Land and Water Resources

Southport Mall

P.O. Box 10631

Jackson, Mississippi 39209

WATER WELL DRILLERS LOG

HARRISON
L2103

10/12/84
date well completed

Lyman Well Co.
firm name

Harrison
county well located

LANDOWNER: Lester Lubber

description of formations encountered

from to

Rt. 1, Box 384
Gulfport 39503
(mailing address)

<u>top soil</u>	<u>0</u>	<u>3</u>
<u>red & yellow clay</u>	<u>3</u>	<u>12</u>
<u>white clay</u>	<u>12</u>	<u>65</u>
<u>yellow clay</u>	<u>65</u>	<u>90</u>
<u>bell spit</u>	<u>90</u>	<u>130</u>
<u>blue clay</u>	<u>130</u>	<u>180</u>
<u>silt</u>	<u>180</u>	<u>280</u>

WELL LOCATION:

sec. 7 T 7 N R 4 E
3 miles W of Gulfport
(distance) (direction) (nearest town)

WELL PURPOSE: home
(home, irrigation, municipal, industrial)

WELL COMPLETION DATA:

(1) diameter (inches) 2"
(2) total depth (feet) 330'
(3) static water level (feet) 30' below above top of ground.

(4) casing PVC, 230'
(material) (depth)
2"
(size) If telescope see back.

(5) screen 10', 230'
(length) (depth to top)
2", PVC
(size) (material)

(6) pump 1, 12
(HP) (yield gpm)
electric
(type power)

(7) electric log NO
(yes or no)
NO
(organization running log)

(8) how well bottom plugged sand
shark


DRILLERS REMARKS: _____

RECEIVED
APR - 9 1986

Department of Natural Resources
Bureau of Land and Water Resources

If well telescopes please sketch and show depths.

GROUND LEVEL

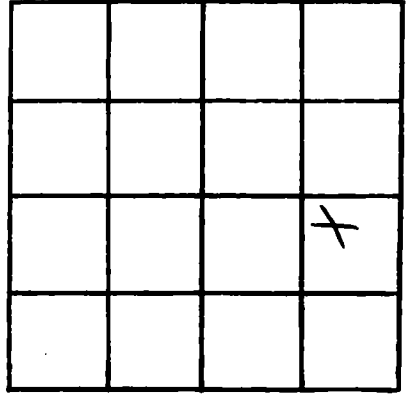

SECTION

1

Please indicate well location X.

ADDITIONAL INFORMATION

If more than one screen,
show locations of each on sketch.