

HARRISON  
L2104

MISSISSIPPI DEPARTMENT OF NATURAL RESOURCES  
Bureau of Land and Water Resources  
Southport Mall  
P.O. Box 10631  
Jackson, Mississippi 39209  
**WATER WELL DRILLERS LOG**

11/18/85 19 Lyman Well Co Harrison  
date well completed firm name county well located

LANDOWNER Mrs. C.R. Sibley  
Rt. 11, Box 274  
Gulfport, Ms 39503  
(mailing address)

WELL LOCATION:  
sec 6 T 7 N R 11 E  
4 miles W of Gulfport  
(distance) (direction) (nearest town)

WELL PURPOSE:  
(home, irrigation, municipal, industrial)

- WELL COMPLETION DATA:
- (1) diameter (inches) 2"
  - (2) total depth (feet) 184'
  - (3) static water level (feet) 28' <sup>below</sup> <sub>above</sub> top of ground.
  - (4) casing PVC, 174'  
(material) (depth)  
2" If telescope see back.  
(size)
  - (5) screen 10', 174'  
(length) (depth to top)  
2", PVC  
(size) (material)
  - (6) pump N/A  
(HP) (yield gpm)  
(type power)
  - (7) electric log NO  
(yes or no)  
NO  
(organization running log)
  - (8) how well bottom plugged sand  
Shack


description of formations encountered	from	to
<u>top soil</u>	<u>0</u>	<u>3</u>
<u>red &amp; yellow soil</u>	<u>3</u>	<u>40</u>
<u>yellow ch</u>	<u>40</u>	<u>85</u>
<u>gray ch</u>	<u>85</u>	<u>90</u>
<u>yellow ch</u>	<u>90</u>	<u>140</u>
<u>gray yellow</u>	<u>140</u>	<u>184'</u>

DRILLERS REMARKS:

**RECEIVED**  
APR 19 1986  
Department of Natural Resources  
Bureau of Land and Water Resources

If well telescopes please sketch and show depths.

GROUND LEVEL

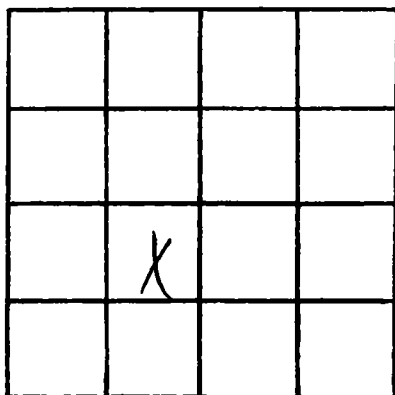

SECTION b

Please indicate well location X.

ADDITIONAL INFORMATION

If more than one screen,  
show locations of each on sketch.