

MISSISSIPPI DEPARTMENT OF NATURAL RESOURCES

Bureau of Land and Water Resources

Southport Mall

P.O. Box 10631

Jackson, Mississippi 39209

WATER WELL DRILLERS LOG

Harrison
L 2108

2/24/86 19 Lyman Well Co. Harrison
 date well completed firm name county well located

LANDOWNER: Chris Greenward
Landon Lakes Lot 12
Gulfport, Ms 3950
 (mailing address)

Description of formations encountered	from	to
Topsoil		1'
Clay	1'	12'
Sandy clay	12'	64'
Clay	64'	118'
Sand	118'	136'
Clay	136'	195'
Sand	195'	215'

WELL LOCATION:
 sec. 10 T. 7 N. R. 11 E.
7 miles N of P.B.
 (distance) (direction) (nearest town)

WELL PURPOSE: Home
 (home, irrigation, municipal, industrial)

- WELL COMPLETION DATA:
- (1) diameter (inches) 2"
 - (2) total depth (feet) 215'
 - (3) static water level (feet) 25' below top of ground.
 - (4) casing PVC 205'
 (material) (depth)
 - 2"
 (size) if telescope see back.
 - (5) screen 10' 205'
 (length) (depth to top)
 - 2" PVC
 (size) (material)
 - (6) pump N/A
 (HP) (yield gpm)
 - (type power)
 - (7) electric log No
 (yes or no)
 - No
 (organization running log)
 - (8) how well bottom plugged sand
shark

RECEIVED


OCT 14 1986

Department of Natural Resources
 Bureau of Land & Water Resources

DRILLERS REMARKS:

If well telescopes please
sketch and show depths.

GROUND LEVEL

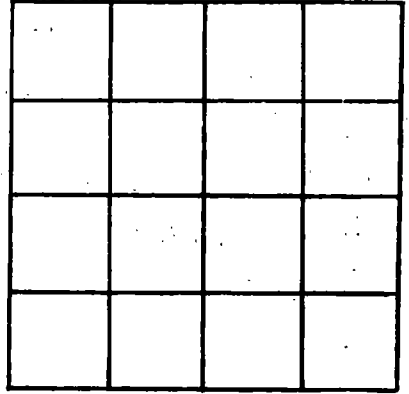

SECTION _____

Please indicate well location X.

ADDITIONAL INFORMATION

If more than one screen,
show locations of each on sketch.