

MISSISSIPPI DEPARTMENT OF NATURAL RESOURCES

Bureau of Land and Water Resources

Southport Mall

P.O. Box 10631

Jackson, Mississippi 39209

WATER WELL DRILLERS LOG

Harrison  
L 2111

5/24/86 19 Lipman Well Co. Harrison  
date well completed firm name county well located

LANDOWNER: Anastasia Taylor  
Rt. 9, Box 173  
Gulfport, Ms 39501  
(mailing address)

WELL LOCATION:  
sec. 8 T. 7 N. R. 11 E.  
5 miles N of Gulfport  
(distance) (direction) (nearest town)

WELL PURPOSE: home  
(home, irrigation, municipal, industrial)

WELL COMPLETION DATA:

- (1) diameter (inches) 2"
- (2) total depth (feet) 688'
- (3) static water level (feet) 12' below top of ground.
- (4) casing PVC 678'  
(material) (depth)  
2" if telescope see back.  
(size)
- (5) screen 10' 678'  
(length) (depth to top)  
2" PVC  
(size) (material)
- (6) pump 1 15  
(HP) (yield gpm)  
electric  
(type power)
- (7) electric log No  
(yes or no)  
No  
(organization running log)
- (8) how well bottom plugged sand  
shark

Description of formations encountered	from	to
Topsoil		1'
Clay	1'	62'
Sand	62'	67'
Clay	67'	83'
Blue Clay	83'	126'
Fine Sand	126'	131'
Blue Clay	131'	284'
Fine Sand	284'	337'
Blue Clay	337'	482'
Fine Sand	482'	541'
Blue Clay	541'	651'
Coarse Sand	651'	688'

**RECEIVED**


OCT 06 1986

Department of Natural Resources  
Bureau of Land & Water Resources

DRILLERS REMARKS:

If well telescopes please sketch and show depths.

GROUND LEVEL

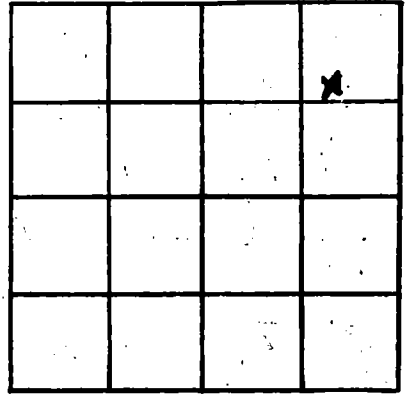

SECTION 8

Please indicate well location X.

ADDITIONAL INFORMATION

If more than one screen, show locations of each on sketch.