

MISSISSIPPI DEPARTMENT OF NATURAL RESOURCES

Bureau of Land and Water Resources

Southport Mall

P.O. Box 10631

Jackson, Mississippi 39209

WATER WELL DRILLERS LOG

Harrison  
L 21/2

7/28/86  
date well completed

Lyman Well  
firm name

Harrison  
county well located

LANDOWNER: Harry C. Wood

description of formations encountered

from

to

Rt. 1, Box 435  
Gulfport, MS 39503  
(mailing address)

<u>Topsoil</u>		<u>1</u>
<u>Sandy Clay</u>	<u>1'</u>	<u>10'</u>
<u>Sand</u>	<u>10'</u>	<u>28'</u>
<u>Sandy Clay</u>	<u>28'</u>	<u>44'</u>
<u>Fine Sand</u>	<u>44'</u>	<u>61'</u>
<u>Blue Clay</u>	<u>61'</u>	<u>125'</u>
<u>Sand</u>	<u>125'</u>	<u>132'</u>
<u>Blue Clay</u>	<u>132'</u>	<u>197'</u>
<u>Sand</u>	<u>197'</u>	<u>213'</u>

WELL LOCATION:

sec. B T. 7 N. R. 11 E.  
6 miles N of Gpt  
(distance) (direction) (nearest town)

WELL PURPOSE: Home  
(home, irrigation, municipal, industrial)

WELL COMPLETION DATA:

- (1) diameter (inches) 2"
- (2) total depth (feet) 213'
- (3) static water level (feet) 23' below top of ground.
- (4) casing PVC, 203'  
(material) (depth)  
2" If telescope see back.  
(size)
- (5) screen 10', 203'  
(length) (depth to top)  
2", PVC  
(size) (material)
- (6) pump N/A  
(HP) (yield gpm)  
electric  
(type power)
- (7) electric log NO  
(yes or no)  
NO  
(organization running log)
- (8) how well bottom plugged sand  
shack

DRILLERS REMARKS:


**RECEIVED**

OCT 28 1986

Department of Natural Resources  
Bureau of Land & Water Resources

If well telescopes please sketch and show depths.

GROUND LEVEL

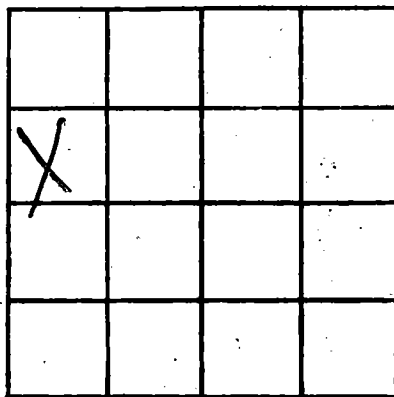

SECTION 18

Please indicate well location X.

ADDITIONAL INFORMATION

Lined area for additional information.

If more than one screen, show locations of each on sketch.