

MISSISSIPPI DEPARTMENT OF NATURAL RESOURCES
Bureau of Land and Water Resources

P.O. Box 10631
Jackson, Mississippi 39209
WATER WELL DRILLERS LOG

COUNTY WELL LOCATED HARRISON	
WELL NUMBER 2-2116	CODED
DATE WELL COMPLETED	

PERMIT NUMBER
NAME OF DRILLING FIRM BRADEN Pump & Well SAUCIER, MS. 39574

NAME & MAILING ADDRESS OF LANDOWNER NORMAN DOUGLAS O'NEAL RD. Rt. 10 Box 180			
GULFPORT, MS. 39503			
WELL LOCATION:	SEC 4	TOWNSHIP 7 S	RANGE 11 W
DISTANCE 2 Miles	DIRECTION SE	NEAREST TOWN LYMAN	
OTHER LANDMARK			
WELL PURPOSE: Home, Irrigation, Municipal, Industrial, Fish Pond, etc. HOME			

PUMP DATA		
PUMP TYPE (Circle One): Submersible Turbine, Jet, Flowing Well, Other (Describe)		
POWER TYPE (Circle One): Electric Tractor, Diesel, Gasoline, Butane, Other (Describe)		
Pump Capacity (GPM) 20	No. of Stages	Setting Depth 120 FT.
PUMP TEST		
Well yielded 20 GPM with a drawdown of _____ ft. after _____ hours of pumping		

WELL DATA		
Well Depth 520	Casing Diameter (In.) 4 X 2	Casing Length (Ft.) 500
Type of Casing PVC	Hole Depth 520	Depth to Static Water Level 60 FT
TYPE OF COMPLETION: (Circle One or More): Natural Development Gravel Packed, Underreamed, Telescoped, Open Hole, Other (Describe)		
Top of Lap Pipe or Reduction in Casing FEET IF TELESCOPED OR MORE THAN ONE SCREEN: USE BACK PAGE		

LOG DATA	
TYPE OF LOG RUN (Circle One): No Log Run Electric, Gamma Ray, Density, Sonic, Neutron, Other (Describe)	
Name of Organization Running Log	

SCREEN DATA		
Diameter - Inches 2	Length - Feet 10	Slot Size - Inches .008
Screen Type W.O.P. - PVC	Depth to Bottom - Feet 510	

GEOLOGIC DATA (Office Use Only)			
Surface Elev.	Geologic Unit	Unit Thickness	Depth to Top
Subs. SWL	Date	Analysis	Aquifer Test


Driller's Remarks

RECEIVED
MAR 30 1987

DESCRIPTION OF FORMATIONS ENCOUNTERED	FROM	TO	FORMATIONS (Continued)	TO
Red Clay	0	10		
White Sand	10	20		
White Clay	30	40		
Brown Sand	40	80		
Blue Clay	80	240		
Fine Sand & Clay Brecks	240	320		
Blue Clay	320	460		
Medium Coarse Sand	460	518		
Blue Clay	518	520+		

IF MORE SPACE IS NEEDED, USE BACK

If well telescopes please sketch and show depths.

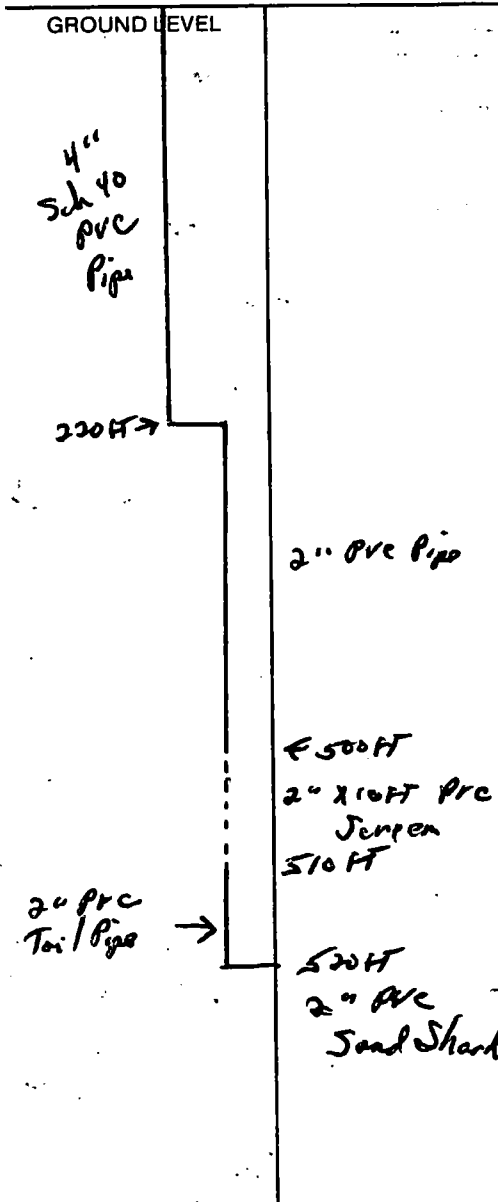

		X	

SECTION 4

Please indicate well location X.

ADDITIONAL INFORMATION

If more than one screen, show location of each on sketch.