

**MISSISSIPPI DEPARTMENT OF NATURAL RESOURCES**  
Bureau of Land and Water Resources

P.O. Box 10631  
Jackson, Mississippi 39209  
**WATER WELL DRILLERS LOG**

COUNTY WELL LOCATED <i>Harrison</i>	
WELL NUMBER <i>L 2118</i>	CODED
DATE WELL COMPLETED <i>7/14/86</i>	

PERMIT NUMBER
NAME OF DRILLING FIRM <i>Hymon Well Co</i>

NAME & MAILING ADDRESS OF LANDOWNER <i>Claude Warden</i> <i>P.O. Box 2445</i> <i>Culbert, MS 39503</i>			
WELL LOCATION:	SEC	TOWNSHIP	RANGE
	<i>13</i>	<i>7 N</i>	<i>11 E</i>
DISTANCE	DIRECTION	NEAREST TOWN	
<i>4</i> Miles	<i>N</i>	of <i>Cpt</i>	
OTHER LANDMARK			
WELL PURPOSE (Home <input checked="" type="radio"/> Irrigation, Municipal, Industrial, Fish Pond, etc.) <i>home</i>			

PUMP DATA		
PUMP TYPE (Circle One): Submersible, Turbine, <input checked="" type="radio"/> Flowing Well, Other (Describe) _____		
POWER TYPE (Circle One): <input checked="" type="radio"/> Electric, Tractor, Diesel, Gasoline, Butane, Other (Describe) _____		
Pump Capacity (GPM) <i>12</i>	No. of Stages <i>2</i>	Setting Depth <i>42'</i> FT.
PUMP TEST		
Well yielded _____ GPM with a drawdown of _____ ft. after _____ hours of pumping		

WELL DATA		
Well Depth <i>230'</i>	Casing Diameter (In.) <i>2"</i>	Casing Length (Ft.) <i>220'</i>
Type of Casing <i>PVC</i>	Hole Depth <i>230</i>	Depth to Static Water Level <i>22'</i>
TYPE OF COMPLETION: (Circle One or More): <input checked="" type="checkbox"/> Gravel Packed, <input type="checkbox"/> Underreamed, <input type="checkbox"/> Telescoped, <input checked="" type="checkbox"/> Natural Development, <input type="checkbox"/> Open Hole, <input type="checkbox"/> Other (Describe) _____		
Top of Lap Pipe or Reduction in Casing		
FEET <input type="checkbox"/> IF TELESCOPED OR MORE THAN ONE SCREEN: USE BACK PAGE		

LOG DATA	
TYPE OF LOG RUN (Circle One): Electric, Gamma Ray, Density, Sonic, <input checked="" type="radio"/> No Log Run, Neutron, Other (Describe) _____	
Name of Organization Running Log	

SCREEN DATA		
Diameter - Inches <i>2"</i>	Length - Feet <i>10'</i>	Slot Size - Inches <i>.006</i>
Screen Type <i>PVC slotted</i>	Depth to Bottom - Feet <i>230'</i>	

GEOLOGIC DATA (Office Use Only)			
Surface Elev.	Geologic Unit	Unit Thickness	Depth to Top
Subs. SWL	Date	Analysis	Aquifer Test

Driller's Remarks <i>None</i>
----------------------------------

DESCRIPTION OF FORMATIONS ENCOUNTERED	FROM	TO	FORM (If continued)	ROW TO
<i>Topsoil</i>		<i>1'</i>		
<i>White Clay</i>	<i>1'</i>	<i>21'</i>		
<i>Yellow &amp; Red Clay</i>	<i>21'</i>	<i>54'</i>		
<i>Sand</i>	<i>54'</i>	<i>62'</i>		
<i>Blue clay</i>	<i>62'</i>	<i>118'</i>		
<i>Sand</i>	<i>118'</i>	<i>121'</i>		
<i>Blue Clay</i>	<i>121'</i>	<i>209'</i>		
<i>Sand</i>	<i>209'</i>	<i>230'</i>		

IF MORE SPACE IS NEEDED, USE BACK


**RECEIVED**

AUG 25 1987

Department of Natural Resources  
Bureau of Land & Water Resources

If well telescopes please  
sketch and show depths.

GROUND LEVEL

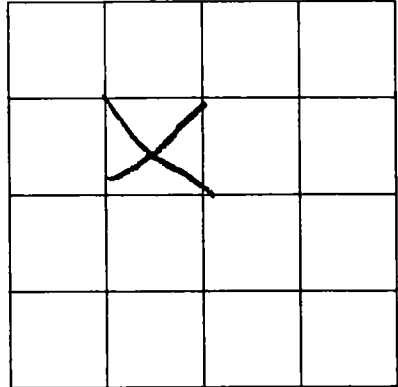

SECTION 13

Please indicate well location X.

ADDITIONAL INFORMATION

Lined area for providing additional information.

If more than one screen,  
show location of each on sketch.